

Amite
G5
6-67

MISSISSIPPI
BOARD OF WATER COMMISSIONERS
416 North State Street
Jackson, Mississippi 39201

CODED

WATER WELL DRILLERS LOG

6-27 1967 date well completed
B. H. Fitzgerald Water Well firm name
Amite county well located


LANDOWNER: Dallas Stoverson
Liberty Rt. Miss
(mailing address)

WELL LOCATION:
sec 3 T 3 N R 3 E
S W
6 miles W of Liberty
(distance) (direction) (nearest town)

WELL PURPOSE: Home
(home, irrigation, municipal, industrial)

- WELL COMPLETION DATA:
- (1) diameter (inches) 4
 - (2) total depth (feet) 107
 - (3) static water level (feet) 60 below above top of ground.
 - (4) casing plastic 96 (material) (depth)
4 (size) if telescope see back.
 - (5) screen 6' 96 (length) (depth to top)
4 plastic (size) (material)
 - (6) pump 1/2 Sub 14 (HP) (yield gpm)
elec (type power)
 - (7) electric log No (yes or no)
 - (8) how well bottom plugged Wood peg

description of formations encountered	from	to
Topsoil Chalk	0	10
Red soil	10	40
Red Chalk	40	80
Sand gravel	50	65
Red Sandy Sand	65	85
Sand progressively coarse	85	102
White Chalk	10	3

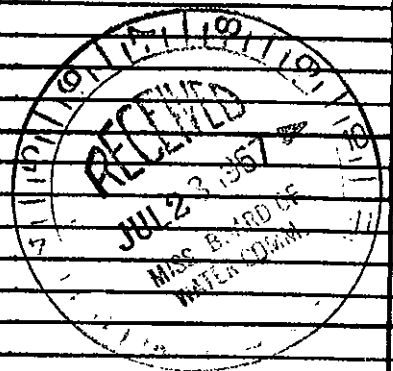

DRILLERS REMARKS: