

AMITE

66

MISSISSIPPI BOARD OF WATER COMMISSIONERS


2-18-65 WATER WELL DRILLERS LOG

CODED

Date: 2-18, 1965, Driller: Chester Reeves County Amite (Name)

(1) Owner of Land	Description & Color of Materials Sand, Clay, Red Clay, Shell, etc.	Thick- ness Feet	Depth Feet
Golden Shuckrow (Name) RFD 1, Liberty (Address)	Surface Clay	20	20
(2) Location: 1/4, 1/4, Sec. 14 T3R3	Sand & gravel	40	60
7 miles NW of Liberty (distance) (direction) (Nearest Town)	white sand	55	9.5
(3) Topography: Hilly (Hilly) (Flat) (Level)	Coarse sand	5	100
(4) Purpose of Well: Domestic (Domestic Irrigation Municipal, Industrial, Other)			
Information upon completion of well:			
(1) Diameter 4 inches.			
(2) Total Depth 100 feet.			
(3) Water Level 80 feet below top of ground.			
(4) Cased to Bottom Size 4'			
(5) Screen: Size 4" Length 7'			
(6) Were any formations sealed against pollution?			
yes, <input checked="" type="checkbox"/> no.			
If YES depth of formation			
Why			
Drillers Remarks: old 2" well bad			

REEVES WELL & PUMP CO.
P. O. BOX 71 PHONE 684-1451
MACOMB, MISS.

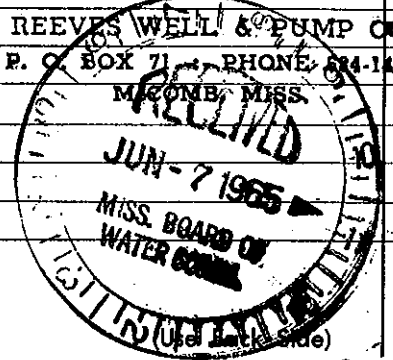

Well No.

Mail this copy to Board of Water Commissioners 429 Miss. St. Jackson, Miss.