

Amite  
69

7-66

MISSISSIPPI BOARD OF WATER COMMISSIONERS

CODED

WATER WELL DRILLERS LOG


Date: July 25, 1966, Driller: W. S. Drilling Co. County: Amite  
(When well drilled) (Name) (Where well is located)

(1) Owner of Land:	Description & Color of Materials Sand, Clay, Red Clay, Shell, etc.	Thick- ness Feet	Depth Feet
<u>W. S. Sterling</u> (Name) <u>RD 3, Liberty</u> (Address)	<u>Clay</u>	<u>10</u>	<u>10</u>
(2) Location: <u>1/4</u> , <u>1/4</u> , Sec. <u>33</u> , T. <u>3</u> , R. <u>3</u>	<u>Red sand gravel</u>	<u>20</u>	<u>30</u>
<u>7</u> miles <u>NW</u> , of <u>Liberty</u> (distance) (direction) (Nearest Town)	<u>Red gravel</u>		
(3) Topography: <u>Hilly</u> (Hilly) (Flat) (Level)	<u>Sand</u>	<u>22</u>	<u>52</u>
(4) Purpose of Well: <u>Domestic</u> (Domestic Irrigation Municipal, Industrial, Other)			

Information upon completion of well:

- (1) Diameter 4 inches.
- (2) Total Depth 52 feet.
- (3) Water Level 27 feet below top of ground.
- (4) Cased to Bottom size 4"
- (5) Screen: Size 4', Length 6'
- (6) Were any formations sealed against pollution?  
 yes,  no.

If YES depth of formation \_\_\_\_\_  
 Why \_\_\_\_\_  
 Drillers Remarks: \_\_\_\_\_  
 Yield in gpm: \_\_\_\_\_  
 Size pump: \_\_\_\_\_  
 Type power: \_\_\_\_\_

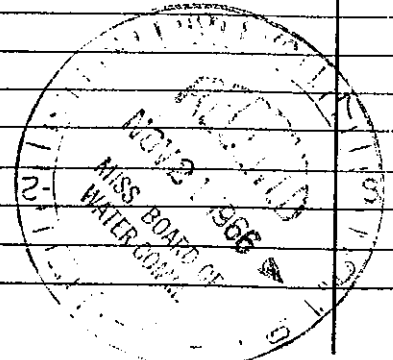

Mail this copy to Board of Water Commissioners 429 Miss. St. Jackson, Miss.