

Amitc
G11
10-66


MISSISSIPPI BOARD OF WATER COMMISSIONERS

CODED

WATER WELL DRILLERS LOG

Date: 31 Oct., 1966, Driller: J. T. Cooney Son County Amitc
(Name)

(1) Owner of Land: <u>Randall</u> (Name) <u>Liberty, Miss</u> (Address)		Description & Color of Materials Sand, Clay, Red Clay, Shell, etc.	Thick- ness Feet	Depth Feet
(2) Location: <u>NE 1/4, NW 1/4, Sec. 1 T3 R3</u>		<u>Clay</u>	<u>100</u>	<u>60</u>
<u>2</u> <u>10</u> miles <u>West</u> , of <u>Liberty</u> (distance) (direction) (Nearest Town)		<u>Clay sand</u>	<u>20</u>	<u>60</u>
(3) Topography: <u>✓</u> (Hilly) (Flat) (Level)		<u>Sand chalk</u>	<u>20</u>	<u>80</u>
(4) Purpose of Well: <u>Domestic</u> (Domestic Irrigation Municipal, Industrial, Other)		<u>Sand Tank</u>	<u>25</u>	<u>105</u>
Information upon completion of well:				
(1) Diameter <u>4</u> inches.				
(2) Total Depth <u>105</u> feet.				
(3) Water Level <u>80</u> feet below top of ground.				
(4) Cased to <u>105'</u> , Size <u>4"</u>				
(5) Screen: Size <u>1/2"</u> , Length <u>6'</u>				
(6) Were any formations sealed against pollution? <u>no.</u>				
If YES depth of formation _____				
Why _____				
Drillers Remarks: _____				

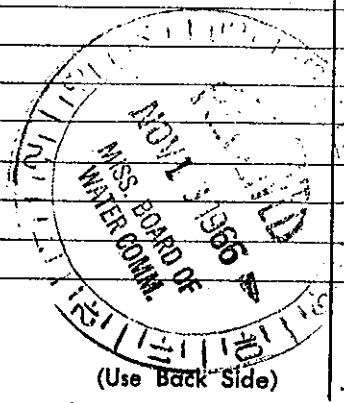

Well No.

Mail this copy to Board of Water Commissioners 429 Miss. St. Jackson, Miss