

AMITE

615

MISSISSIPPI BOARD OF WATER COMMISSIONERS

CODED

9-1-65


2693

WATER WELL DRILLERS LOG

Date: 9-1, 1965, Driller: Chester Belue County Amite (Name)

		Description & Color of Materials Sand, Clay, Red Clay, Shell, etc.	Thick- ness Feet	Depth Feet
(1) Owner of Land: <u>Ed. Judge, Jr.</u> (Name) <u>RFD, Slator</u> (Address)		<u>Red Clay</u>	<u>17</u>	<u>17</u>
		<u>Clay</u>	<u>63</u>	<u>80</u>
		<u>Sandy gravel</u>	<u>20</u>	<u>100</u>
		<u>gravel</u>	<u>10</u>	<u>110</u>
(2) Location: $\frac{1}{4}$, $\frac{1}{4}$, Sec <u>34 T. 3 R. 3</u> , <u>7</u> mile <u>East</u> of <u>Slator</u> (distance) (direction) (Nearest Town)				
(3) Topography: <u>Hilly</u> (Hilly) (Flat) (Level)				
(4) Purpose of Well: <u>Domestic</u> (Domestic Irrigation Municipal, Industrial, Other) <u>Dairy</u>				
Information upon completion of well:				
(1) Diameter <u>4</u> inches.				
(2) Total Depth <u>110</u> feet.				
(3) Water Level: <u>5.5</u> feet below top of ground.				
(4) Cased to <u>Bottom</u> , Size <u>4</u>				
(5) Screen: Size <u>4"</u> , Length <u>7'</u>				
(6) Were any formations sealed against pollution? _____ yes, <input checked="" type="checkbox"/> no.				
If YES depth of formation _____				
Why _____				
Drillers Remarks: <u>good well</u> <u>Bad</u>				

CODED

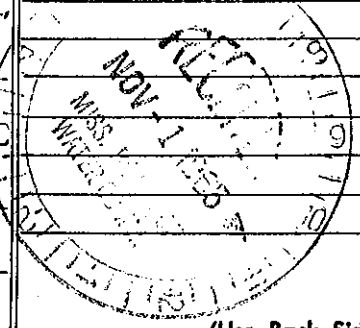

(Use Back Side)

Well No.

Mail this copy to Board of Water Commissioners 429 Miss. St. Jackson, Miss.