

AMITE

MISSISSIPPI BOARD OF WATER COMMISSIONERS

CODED

591
2-23-65 WATER WELL DRILLERS LOG

Date: 2-23, 1965, Driller: Chester Reeves County Amite
(Name)

(1) Owner of Land:	Description & Color of Materials Sand, Clay, Red Clay, Shell, etc.	Thick- ness Feet	Depth Feet
WAYNE TOLIV (Name) RFD 5, Liberty (Address)	Surface Clay Sand & gravel	18	18
(2) Location: 1/4, 1/4 Sec. 35 T 3 R 3 4.5 miles west of Liberty (distance) (direction) (Nearest Town)			
(3) Topography: Hilly (Hilly) (Flat) (Level)			
(4) Purpose of Well: Domestic (Domestic Irrigation Municipal, Industrial, Other)			

Information upon completion of well:

- (1) Diameter 4 inches
- (2) Total Depth 145 feet
- (3) Water Level 93 feet below top of ground
- (4) Cased to Bottom, Size 4"
- (5) Screen: Size 4", Length 7'
- (6) Were any formations sealed against pollution?
yes, no.


If YES depth of formation

Why

Drillers Remarks:

old 2" well inadequate

CODED

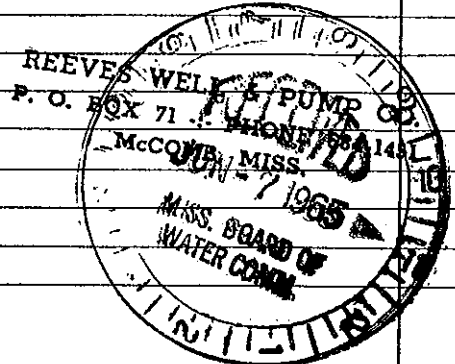

(Use Back Side)

Well No.

Mail this copy to Board of Water Commissioners 429 Miss. St. Jackson, Miss.