

AMITE
 AG 22
 6-7-63 2600
 Date: 6-7, 1963, Driller: Chester Reeves County Amite
 (Name)

CODED


(1) Owner of Land: James Whittington
 (Name)
R.F. Duster
 (Address)
 (2) Location: 1/4, 1/4, Sec. 5 T3 R3
8 miles N.W. of Duster
 (distance) (direction) (Nearest Town)
 (3) Topography: Hilly
 (Hilly) (Flat) (Level)
 (4) Purpose of Well: Domestic
 (Domestic Irrigation, Municipal, Industrial, Other)

Description & Color of Materials Sand, Clay, Red Clay, Shell, etc.	Thick- ness Feet	Depth Feet
<u>Clay</u>	<u>15</u>	<u>15</u>
<u>yellow sand</u>	<u>45</u>	<u>60</u>
<u>white chalk</u>	<u>52</u>	<u>112</u>
<u>small gravel</u>	<u>8</u>	<u>120</u>
<u>sand</u>		

CODED

Information upon completion of well:

(1) Diameter: 4 inches.
 (2) Total Depth: 120 feet.
 (3) Water Level: 95 feet below top of ground.
 (4) Cased to: bottom size 4
 (5) Screen: Size 4", Length 4'
 (6) Were any formations sealed against pollution?
 _____ yes, no.

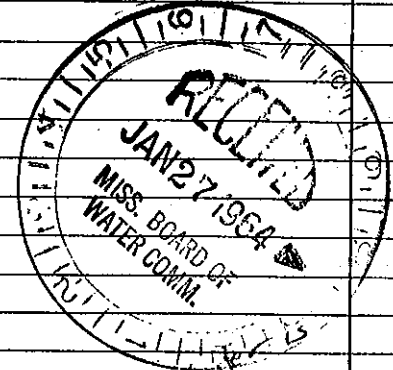

If YES depth of formation _____
 Why _____
 Drillers Remarks: old well
No good

REEVES WELL & PUMP CO.
 P. O. BOX 71 PHONE 684-1461
 McCOMB, MISS.

(Use Back Side)

Mail this copy to Board of Water Commissioners 429 Miss. St. Jackson, Miss

Well No.