

Amite  
 G 2012  
 6-30-81

MISSISSIPPI  
 BOARD OF WATER COMMISSIONERS  
 416 North State Street  
 Jackson, Mississippi 39201

WATER WELL DRILLERS LOG

6-30 1981 date well completed  
 Fitzgerald Well Co. firm name  
 Amite county well located


LANDOWNER:  
 Bill Taylor  
 Rt 2 Clinton ms.  
 (mailing address)

description of formations encountered	depth	
	from	to
Red clay	0	20
Red sand	20	110
Coarse sand & gravel	110	130

WELL LOCATION:  
 sec. 26 T. 3 N. R. 3 E.  
 S  
 5 miles W of Liberty  
 (distance) (direction) (nearest town)

WELL PURPOSE:  
 (home, irrigation, municipal, industrial)

- WELL COMPLETION DATA:
- (1) diameter (inches) 4
  - (2) total depth (feet) 130
  - (3) static water level (feet) 100 below top of ground.
  - (4) casing PVC 122 (material) (depth)  
 4 (size) if telescope see back.
  - (5) screen 8 122 (length) (depth to top)  
 4 (size) PVC (material)
  - (6) pump 1/2 10 (HP) (yield gpm)  
 60 (type power)
  - (7) electric log yes (yes or no)  
 (organization running log)
  - (8) how well bottom plugged 1/2 blk

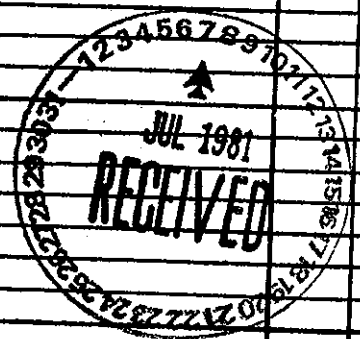

DRILLERS REMARKS: