

Amite
 G 2021
 3-5-85

MISSISSIPPI DEPARTMENT OF NATURAL RESOURCES
 Bureau of Land and Water Resources
 Southport Mall
 P.O. Box 10631
 Jackson, Mississippi 39209
WATER WELL DRILLERS LOG

March 5 1985 Acers Well Ser Amite
 date well completed film name county well located

LANDOWNER:
C. H. Rancin Craft
Rt Liberty
 (mailing address)


description of formations encountered	from to	
	from	to
<u>Red sandstone clay</u>	<u>0</u>	<u>30</u>
<u>sand & gravel</u>	<u>30</u>	<u>90</u>
<u>pink chalk</u>	<u>90</u>	<u>120</u>
<u>plagiomud formation</u>	<u>120</u>	<u>142</u>

WELL LOCATION:
 sec. 36-T-3 N-W-3 E
3 1/2 miles E-SE of Liberty
 (distance) (direction) (nearest town)

WELL PURPOSE: Water
 (home, irrigation, municipal, industrial)

- WELL COMPLETION DATA:
- (1) diameter (inches) 4
 - (2) total depth (feet) 142
 - (3) static water level (feet) 100' below above top of ground.
 - (4) casing plastic, bottom
 (material) (depth)
4" if telescope see back.
 (size)
 - (5) screen 10 13 1/2
 (length) (depth to top)
4" plastic
 (size) (material)
 - (6) pump weather
 (HP) (yield gpm)
electric
 (type power)
 - (7) electric log no
 (yes or no)
 (organization running log)
 - (8) how well bottom plugged back wash

DRILLERS REMARKS:
old well damaged by shot hole blow

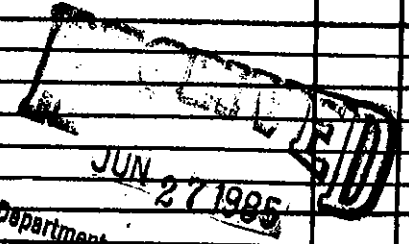

Department of Natural Resources
 Bureau of Land & Water Resources