

Amite
H3
B-66

MISSISSIPPI BOARD OF WATER COMMISSIONERS

CODED

WATER WELL DRILLERS LOG

Date: Aug 25, 1966, Driller: Pelevs well & pump County: Amite
(When well drilled) (Name) (Where well is located)

(1) Owner of Land:	Description & Color of Materials	Thick-ness Feet	Depth Feet
<u>F.W. Graves</u> (Name) <u>RFD 1-A-Liberty</u> (Address)	<u>Red clay</u>	<u>25</u>	<u>25</u>
	<u>Red Sand & gravel</u>	<u>35</u>	<u>60</u>
(2) Location: <u>1/4, 1/4, Sec. 18 T3R4</u>	<u>Red sandy sand</u>	<u>10</u>	<u>70</u>
<u>4</u> miles <u>N.W.</u> of <u>Liberty</u> (distance) (direction) (Nearest Town)	<u>white sand blue clay</u>	<u>70</u>	<u>140</u>
(3) Topography: <u>Hilly</u> (Hilly) (Flat) (Level)	<u>Coarse sand</u>	<u>20</u>	<u>160</u>
(4) Purpose of Well: <u>Domestic</u> (Domestic Irrigation Municipal, Industrial, Other)			

Information upon completion of well:

- (1) Diameter 4 inches.
- (2) Total Depth 160 feet.
- (3) Water Level 90 feet below top of ground.
- (4) Cased to Bottom Size 4"
- (5) Screen: Size 4", Length 6'
- (6) Were any formations sealed against pollution?
_____ yes, no.

If YES depth of formation _____


Why _____

Drillers Remarks: _____

Yield in gpm: 20

Size pump: 1/2 H.P. pump

Type power: Electric

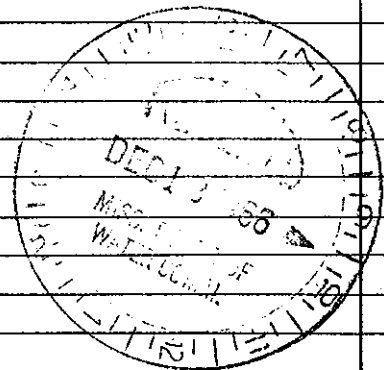

Mail this copy to Board of Water Commissioners 429 Miss. St. Jackson, Miss.