

Amite
H5
3-67

MISSISSIPPI
BOARD OF WATER COMMISSIONERS
416 North State Street
Jackson, Mississippi 39201

CODED

WATER WELL DRILLERS LOG

3-9-1967 date well completed
Fitzgerald W Well Service firm name
Amite county well located


LANDOWNER: BE Zeigler
Rt 1 Liberty
(mailing address)

description of formations encountered	from	to
Top Soil + Red Sand	0	30
Red Sand + gravel	30	60
Gravelly Sand	60	95
Water Saturated gravel	95	118
Chalk	118	

WELL LOCATION:
sec. 26 T 3 N R 4 E
S W
3 1/2 miles N of Liberty
(distance) (direction) (nearest town)

WELL PURPOSE:
(home, irrigation, municipal, industrial)

- WELL COMPLETION DATA:
- (1) diameter (inches) 4
 - (2) total depth (feet) 118
 - (3) static water level (feet) 80 below top of ground.
 - (4) casing plastic 110
(material) (depth)
4 (size) If telescope see back.
 - (5) screen 8' 110'
(length) (depth to top)
4 (size) plastic 15 (material)
 - (6) pump 1/2 hp 15'
(HP) (yield gpm)
300 (type power)
 - (7) electric log No
(yes or no)
(organization running log)
 - (8) how well bottom plugged Ward peg

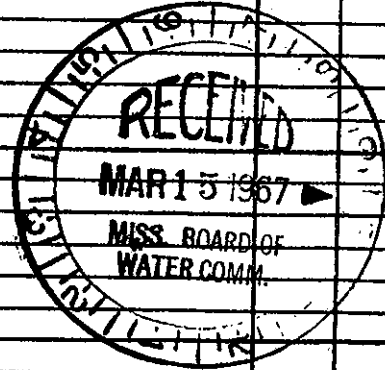

DRILLERS REMARKS: