

AMITE

MISSISSIPPI BOARD OF WATER COMMISSIONERS

H10

750

3-18-63

WATER WELL DRILLERS LOG

CODED

Date: 3-18, 1963, Driller: Chester Reeves County Amite
(Name)

(1) Owner of Land: Horace Kirkland
(Name)
RFD Liberty
(Address)

(2) Location: 1/4, 1/4 Sec. 34 T. 3 R. 7
3 miles north of Liberty
(distance) (direction) (Nearest Town)

(3) Topography: Hilly
(Hilly) (Flat) (Level)

(4) Purpose of Well: Domestic
(Domestic Irrigation, Municipal, Industrial, Other)

Description & Color of Materials Sand, Clay, Red Clay, Shell, etc.	Thick- ness Feet	De- pth Feet
<u>Red clay</u>	<u>30</u>	<u>30</u>
<u>Red sand</u>	<u>90-110</u>	
<u>Chalky sand</u>	<u>5</u>	<u>115</u>
<u>sand & gravel</u>	<u>10</u>	<u>125</u>

Information upon completion of well:

(1) Diameter 4 inches.

(2) Total Depth 125 feet.

(3) Water Level 95 feet below top of ground.

(4) Cased to bottom, Size 4"

(5) Screen: Size 4", Length 4"

(6) Were any formations sealed against pollution?
_____ yes, no.


If YES depth of formation _____

Why _____

Drillers Remarks: New
House

CODED

REEVES WELL & PUMP CO.
P. O. BOX 71 P. O. NO. 684-1451
MOBILE, MISS.

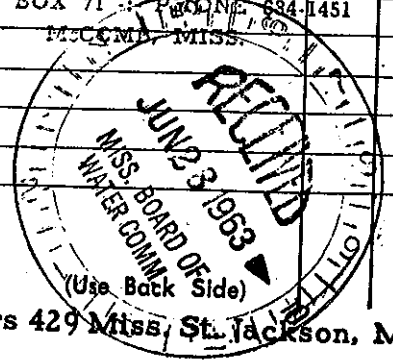

Well No.

Mail this copy to Board of Water Commissioners 429 Miss. St. Jackson, Miss.