

AMITE MISSISSIPPI BOARD OF WATER COMMISSIONERS

H 12

1186

8-14-64 WATER WELL DRILLERS LOG

CODED

Date: 8-14, 1964, Driller: Chester Lewis County, Amite
(Name)

(1) Owner of Land:	Description & Color of Materials Sand, Clay, Red Clay, Shell, etc.	Thick- ness Feet	Depth Feet
(Name) <u>Fuelto T. James</u> (Address) <u>RFD Liberty - 7113</u>	<u>Red clay</u> <u>Red sand</u>	<u>18</u> <u>60</u>	<u>18</u> <u>60</u>
(2) Location: $\frac{1}{4}$, $\frac{1}{4}$, Sec. <u>07</u> , T. <u>00</u> , R. <u>09</u>	<u>Sand & gravel</u> <u>sand rocks</u>		
(3) Topography: <u>6</u> miles <u>south</u> of <u>Liberty</u> (distance) (direction) (nearest town)			
(4) Purpose of Well: <u>Domestic</u> (Domestic Irrigation, Municipal, Industrial, Other)			

Information upon completion of well:


- (1) Diameter 4 inches.
- (2) Total Depth 84 feet.
- (3) Water Level 66 feet below top of ground.
- (4) Cased to Bottom size 4"
- (5) Screen: Size 4", Length 7'
- (6) Were any formations sealed against pollution?
 yes, no.

If YES depth of formation _____

Why _____

Drillers Remarks: old well
Sanded

CODED

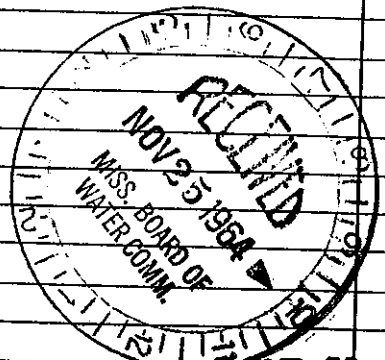

REEVES WELL & PUMP CO.
 P. O. BOX 71 - PHONE 684-1451
 McCOMB, MISS

Well No.

(Use Back Side)

Mail this copy to Board of Water Commissioners 429 Miss. St. Jackson, Miss