

AMITE

H25

MISSISSIPPI BOARD OF WATER COMMISSIONERS

622

WATER WELL DRILLERS LOG

CODED

5-10-63

Date: 5-10, 1963, Driller: Chester Reeves County: Smith

| (1) Owner of Land: | Description & Color of Materials Sand, Clay, Red Clay, Shell, etc. | Thick- ness Feet | De p |
|--|---|------------------------|---------|
| Name: H. J. Whittington Address: H.D. Liberty | Clay | 20 | 20 |
| (2) Location: 1/4, 1/4, Sec. 16 T. 3 R. 4 | Red sand | 10 | 30 |
| (3) Topography: 7 miles N.W. of Liberty | gravel & sand at 45 ft | 15 | 45 |
| (4) Purpose of Well: Domestic | white chalk | 25 | 120 |
| | red clay & sand | 30 | 150 |
| | white sand | 20 | 170 |

Information upon completion of well:

- (1) Diameter 4 inches.
- (2) Total Depth 170 feet.
- (3) Water Level 80 feet below top of ground.
- (4) Cased to Ballans, Size 4"
- (5) Screen: Size 4", Length 4'
- (6) Were any formations sealed against pollution?
yes, no.

If YES depth of formation _____


Why _____

Drillers Remarks: Bad well

Bad

CODED

REEVES WELL & PUMP CO.
P. O. BOX 71 -- PHONE 884-1451
MEMPHIS

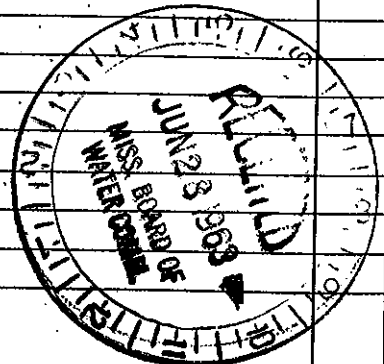

(Use Back Side)

Mail this copy to Board of Water Commissioners 429 Miss. St. Jackson, Miss.

Well No.