	ata Wall Danart	
	ate Well Report	For Office Use Only:
	rt 1 - Driller's Log	Aquifer: 473
Permit #: Office o	epartment of Environmental Quality f Land and Water Resources	•
	P.O. Box 2309	Well #:
Driller: Fitzgeveld Wellfaco	Jackson, MS 39225	L. S. Elevation:
Date drilling completed: 11-24-10	(601)961- 5210 (601)961- 5228 (fax)	
		E-log #:
State Law requires that this report be prepared b	y the license holder responsible for i	the work and filed with the
Department at the above address within 30 days	of completion of drilling of the well	or borehole. orehole Location
Information on Well Owner (Landowner if borehole is not for a water well)		
	Latitude: 51 . 14 . 4K.	6 Longitude: <u>60° 50; 3).</u>
Owner Name Lynn Brumbelou		- charactional Surray
Mailing Address: Huy 567	Method of Lat/Long (circle or	ie). Conventional Survey,
	USGS quad, Hand-held	GPS, Survey-grade GPS
	- 51155 V 55	Twn <u>3N</u> Rng YE
hberry ms.	<u> / w /4 / 0 /4 Sec_</u>	
City State Zip Co	de Distance Direction	Nearest Town
•	Miles	of
Telephone No. ()		
1-24-10 W	/ell / Borehole Data	
	11-24-10 Hole depth: 104-	Hole diameter 811
Date drilling started: Date drilling completed:		Hole diameter.
Location of the source of any surface water used for drillin	ıg:	
Method of dosing and volume of Chlorine used in drilling	and development:	
Logs run (circle all applicable): No log run Electric Ga	mma Ray Density Sonic Neutron	Other:
Name of organization running log(s):		
Purpose of borehole (check one): Water Well Geotechi		d Source Heat Pump
Purpose of borehole (check one): Water Well Georechi	nical/Geological Investigation Ground	
Seismic Survey Other	r (describe)	
If drilling is not related to water well c	onstruction, skip the remainder of this b	lock
Purpose of Well (check one): HomeIndustrial Put	olic Supply Irrigation Fish Culture	Other:
-		
If a flowing well, method of flow regulation: Valve	Other (describe)	
Static Water Level:feet above or below (c	ircle one) land surface Date measured:	11-24-10
Well depth: <u>104</u> Well grouted to a depth of <u>10</u> fee	t Type of grout (circle one): Neat Cer	ment Bentonite Mix
Casing length: <u>94</u> feet Casing diameter:		
Screen length: <u>/0</u> feet Screen diameter:	Y"inches Type of screen:	pic
Screen slot size:inches Setting dept	he From 94 front to 16	feet
Type of completion (circle all applicable): Gravel packet	Underreamed Telescoped Ope	n hole Natural Development
	be):	
Top of lap pipe or reduction in casing:	feet. If telescoped or more than one scr	<u>een, descride on next dage</u>
	······································	Form: OLWR-SWR-1A (04/08

۲


5

## RECEIVED

DEC 2 1 2010 BY: OLWR

H 73


## The sketch below only required for water wells

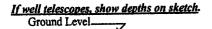

Description of formations encountered must be provided for all wells and boreholes, unless specifically exempted by regulations

	Description of Formations Encountered	From (depth)	To (depth)
-		Ground Level	
	cluye	6	15
	Sunde	15	30
	Cluster	30	80
	Sanda	80	90
	(our Sand)	90	104
		<u> </u>	
		<u></u>	
		1	

If more than one screen, show location of each on sketch

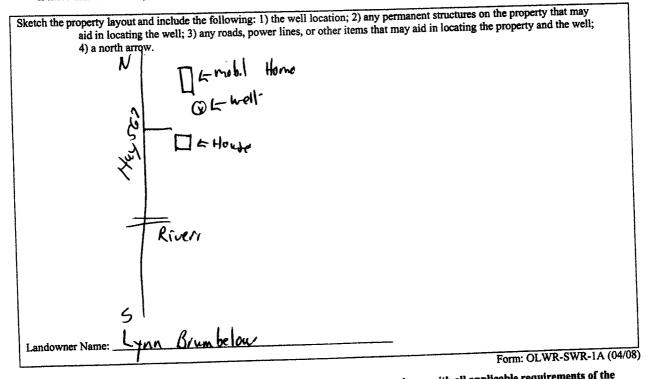

I certify that the well/borehole was drilled, constructed, and completed in accordance with all applicable requirements of the Mississippi Department of Environmental Quality and the Mississippi Department of Health regulations, if applicable, and state

laws 11-24-10.  $\mathcal{O}$ BIAd Fitzerald Date

RECEIVED

Print Name of Responsible Licensee and License No.

Signature of Licensee

DEC 2 1 2010 BY: OLWR

County: <u>Am-te</u> Permit #: Driller: <u>Fitzgeneld</u> <u>Well</u> Sevoo Date completed: <u>11-24-10</u> , <u>Corre information from block on Port 1</u> This and the prove block on Port 1 This and the prove block on Port 1	ELL REPORT   *art 2   *a
report must be effected and back merts filed with the Department Well Owner Internation Dwner Name: Lfnn Bruffelow Mailing Address: Lfwf 5 & 7 Loberty MS: City State Zip Code	Well Location   Latitude: 31° 14′ 48′.6 ″ Longitude: 90° 50′ 32.8″   Method of Lat/Long (check one): Conventional Survey
Parage Type Circle one   Air Lift Jet   Bucket Piston   Bucket Piston   Centrifugal Rotary   Flowing Well   Other (specify):      Date Pump Installed: /// 2/ - //0,   Rated Pump Capacity:    Gallons Per Minute	Power Type Circle one   Diesel Engine Gasolino Engine Natural Gas   Electric Moldy Hand Tractor PTO   Windmill Other (specify):
Pump Test Data   Date Well Tested:   Static Water Level (A):   Feet Below Land Surface   Pumping Water Level (B):   Feet Below Land Surface   Drawdown [(B) - (A)]:   Feet Below Land Surface   Test Pumping Rate:   Gallons Per Minute   Duration of Pump Test (minimum 4 bours):	Method of Messaving Water Level Circle one Air Line Electric Measuring Line Steel Tape Other (specify): For flowing well, measured shut in head:feet Well yieldedfreet afterhours of pumping

DEC 2 1 2010 BY: OLWR