

Amite
 H 2000
 10-21-75

146

MISSISSIPPI
 BOARD OF WATER COMMISSIONERS
 416 North State Street
 Jackson, Mississippi 39201

WATER WELL DRILLERS LOG

Jan 21 1975 *Recreational Well Drilling* Amite
 date well completed firm name county well located

LANDOWNER:
George C. Thompson
Rt. 1 Liberty
 (mailing address)

description of formations encountered	from	to
<i>Red Clay</i>	0	20
<i>Red sand</i>	20	40
<i>sand & gravel</i>	40	65
<i>loam</i>	65	80
<i>sand & peagrand</i>	80	102


WELL LOCATION:
 sec. 35 T. 3 N R. 4 E
 2 miles N-NE of Liberty
 (distance) (direction) (nearest town)

WELL PURPOSE: *Home*
 (home, irrigation, municipal, industrial)

- WELL COMPLETION DATA:
- (1) diameter (inches) 4"
 - (2) total depth (feet) 102
 - (3) static water level (feet) 50 below top of ground
 - (4) casing plastic bottom
 (material) (depth)
 - (size) 1 if telescope see back.
 - (5) screen 6" 9 ft
 (length) (depth to top)
 - (size) 4" (material) plastic
 - (6) pump Sub 10
 (HP) (yield gpm)
 - (type power) elect
 - (7) electric log no
 (yes or no)
 - (organization running log)

(8) how well bottom plugged
no bottom plug

DRILLERS REMARKS:
new house site

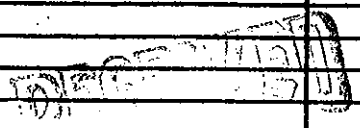

JAN 12 1975

OF WATER COMM