

AMITE
H 2028
8/1/80
Aug 1 - 1980

MISSISSIPPI
 BOARD OF WATER COMMISSIONERS
 416 North State Street
 Jackson, Mississippi 39201

WATER WELL DRILLERS LOG

80 Rivers Well Dr Amite
 firm name county well located

LANDOWNER:
Parcey McCoy
Rt Liberty
 (mailing address)

WELL LOCATION:
 sec. 20 T. 3 N. R. 4 E
 (distance) miles (direction) of (nearest town)

description of formations encountered	from	to
<u>Red Clay</u>	<u>0</u>	<u>30</u>
<u>Red sand</u>	<u>30</u>	<u>65</u>
<u>sea gravel</u>	<u>65</u>	<u>76</u>
<u>white Chalk</u>	<u>76</u>	<u>105</u>
<u>medium coarse sand</u>	<u>105</u>	<u>131</u>

WELL PURPOSE: Tractor
 (home, irrigation, municipal, industrial)

WELL COMPLETION DATA:

(1) diameter (inches) 4"

(2) total depth (feet) 131

(3) static water level (feet) 80 below top of ground

(4) casing plastic (material) bottom (depth)

(size) If telescope see back.

(5) screen 5' (length) 126' (depth to top)

(size) 4" (material) plastic


(6) pump 1/2 (HP) 10 (yield gpm)

(type power) list

(7) electric log no (yes or no)

(organization running log)

(8) how well bottom plugged Crack Wash Valve

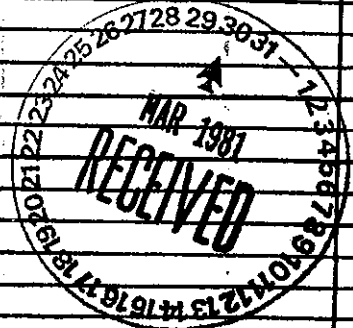

DRILLERS REMARKS: