

Amite
H 2035
8-30-81

MISSISSIPPI
BOARD OF WATER COMMISSIONERS
416 North State Street
Jackson, Mississippi 39201

WATER WELL DRILLERS LOG

6-30 1981 date well completed
H. J. Smith & Co. firm name
Amite county well located

LANDOWNER:

Haller Anderson
R.R. Libert, Mo.
(mailing address)

WELL LOCATION:

sec. 22 T-3 N R 4 E S W
5 miles H of Tipton
(distance) (direction) (nearest town)


WELL PURPOSE:
(home, irrigation, municipal, industrial)

WELL COMPLETION DATA:

- (1) diameter (inches) 4
- (2) total depth (feet) 130
- (3) static water level (feet) 105 below top of ground.
- (4) casing PVC 122 (material) (depth)
4 (size) if telescope see back.
- (5) screen 8 (length) 122 (depth to top)
4 (size) PVC (material)
- (6) pump 1/2 (HP) 10 (yield gpm)
Electric (type power)
- (7) electric log no (yes or no)
- (organization running log) _____
- (8) how well bottom plugged bad

description of formations encountered

description of formations encountered	from	to
Red clay	0	20
Red sand	20	120
Coarse sand & gravel	120	130

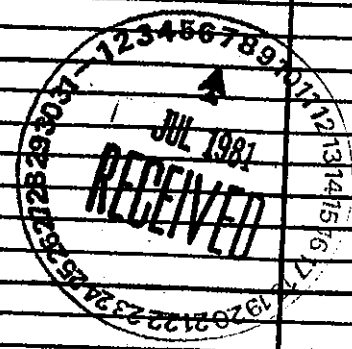

DRILLERS REMARKS: