

Amite
77
10-66


MISSISSIPPI BOARD OF WATER COMMISSIONERS

WATER WELL DRILLERS LOG

CODED

Date: 28 Oct., 1966, Driller: J. T. Cunningham County Amite
(Name)

(1) Owner of Land:	Description & Color of Materials Sand, Clay, Red Clay, Shell, etc.	Thick- ness Feet	Depth Feet
<u>John Wells Jr.</u> (Name) <u>Liberty, Miss.</u> (Address)	<u>Clay</u>	<u>30</u>	<u>30</u>
(2) Location: <u>N 1/4, S 1/4, Sec. 10 T 3 R 5</u>	<u>Chalk</u>	<u>20</u>	<u>50</u>
<u>8</u> miles <u>N-E</u> , of <u>Liberty</u> (distance) (direction) (Nearest Town)	<u>Sand & Chalk</u>	<u>20</u>	<u>70</u>
(3) Topography: <input checked="" type="checkbox"/> (Hilly) <input type="checkbox"/> (Flat) <input type="checkbox"/> (Level)	<u>Sand & Rock</u>	<u>38</u>	<u>108</u>
(4) Purpose of Well: <u>Domestic</u> (Domestic Irrigation Municipal, Industrial, Other)			
Information upon completion of well:			
(1) Diameter <u>4 1/2</u> inches.			
(2) Total Depth <u>108'</u> feet.			
(3) Water Level <u>75</u> feet below top of ground.			
(4) Cased to <u>108'</u> , Size <u>4"</u>			
(5) Screen: Size <u>4"</u> , Length <u>6'</u>			
(6) Were any formations sealed against pollution?			
_____ yes, <input checked="" type="checkbox"/> no.			
If YES depth of formation _____			
Why _____			
Drillers Remarks: _____			

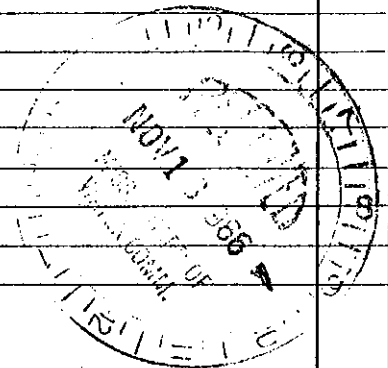

(Use Back Side)

Well No.

Mail this copy to Board of Water Commissioners 429 Miss. St. Jackson, Miss.