

Amite
87
8-68

MISSISSIPPI
BOARD OF WATER COMMISSIONERS
416 North State Street
Jackson, Mississippi 39201

CODED

WATER WELL DRILLERS LOG

8 29 1968 date well completed
B. Ferguson Water Well Amite firm name
county well located

LANDOWNER: Roy W. Hatch
Liberty Rt 1 Miss
(mailing address)

description of formations encountered	from	to
top soil & clay	0	95
Red sand	25	60
yellow sand	60	85
gravel heavy	85	105

WELL LOCATION:
sec. 8 T. 3 N. R. 5 E
8 miles NE Liberty
(distance) (direction) (nearest town)

WELL PURPOSE: home
(home, irrigation, municipal, industrial)

WELL COMPLETION DATA:

(1) diameter (inches) 4

(2) total depth (feet) 107

(3) static water level (feet) 65 below above top of ground.

(4) casing plastic 96
(material) (depth)

(size) 4 If telescope see back.

(5) screen 6 96
(length) (depth to top)

(size) 1/2 (material) Schro


(6) pump 1/2 sub 12
(HP) (yield gpm)

3/4 sec 230 v
(type power)

(7) electric log no
(yes or no)

(organization running log)

(8) how was bottom plugged 1/2 to top

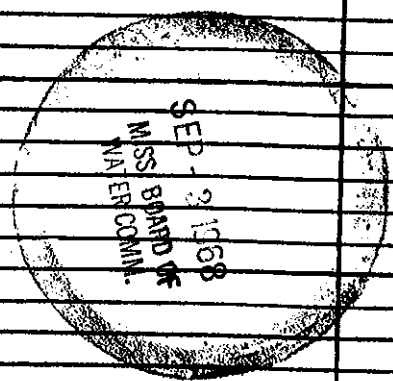

DRILLERS REMARKS: