

AMITE

MISSISSIPPI BOARD OF WATER COMMISSIONERS

K2

K 300

10-7-60

WATER WELL DRILLERS LOG CODED

COL

Date: 10-7, 1960, Driller: Chester Reeves County Amite

(Name)

(1) Owner of Land: T.J. Robinson
(Name)
RFD 2, Smithdale, Miss
(Address)

(2) Location: 1/4, 1/4, Sec. 4 T. 36
12 miles upst of McComb
(distance) (direction) (Nearest Town)

(3) Topography: Level
(Hilly) (Flat) (Level)

(4) Purpose of Well: Domestic
(Domestic Irrigation
Municipal, Industrial, Other)

Description & Color of Materials
Sand, Clay, Red Clay, Shell, etc.Thick-
ness
FeetDepth
Feet

Clay	18	18
Red sand & chalk	22	40
Pink sandy sand	10	50
Coarse white sand	5	55
sand & small gravel	8	63


Information upon completion of well:

- (1) Diameter 4 inches.
- (2) Total Depth 63 feet.
- (3) Water Level 38 feet below top of ground.
- (4) Cased to Bottom, Size 4'
- (5) Screen: Size NONE, Length
- (6) Were any formations sealed against pollution?
yes, ☒ no.

If YES depth of formation

Why

Drillers Remarks:

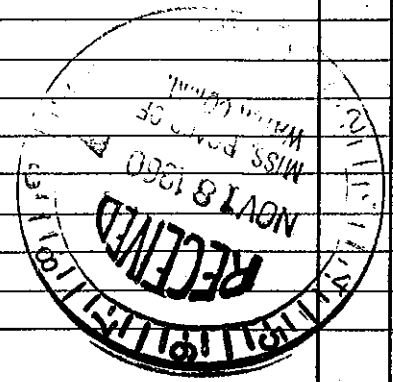

(Use Back Side)

Well No.

Mail this copy to Board of Water Commissioners 429 Miss. St. Jackson, Miss.