

AMITE MISSISSIPPI BOARD OF WATER COMMISSIONERS

K6

1-7-63

WATER WELL DRILLERS LOG CODED

Date: 1-7, 1963, Driller: Chester Reeves County Amite

(Name)

(1) Owner of Land	Description & Color of Materials Sand, Clay, Red Clay, Shell, etc.	Thick- ness Feet	Depth Feet
Jamie Brunfield <small>(Name)</small> RFD, Liberty <small>(Address)</small>	Red clay	25	25
(2) Location: 1/4, 1/4, Sec. 30 T.3.R.6,	Red sandy clay	55	80
12 miles west of McComb <small>(distance)</small> <small>(Nearest Town)</small>	Pea gravel & Sand	9	89
(3) Topography: <u>Hilly</u>			
(4) Purpose of Well: <u>Domestic</u>			

Information upon completion of well:


- (1) Diameter 4 inches.
- (2) Total Depth 89 feet.
- (3) Water Level 76 feet below top of ground.
- (4) Cased to bottom size 4"
- (5) Screen: Size 4", Length 4'
- (6) Were any formations sealed against pollution?  
 yes,  no.

If YES depth of formation \_\_\_\_\_

Why \_\_\_\_\_

Drillers Remarks: old well

Bad.

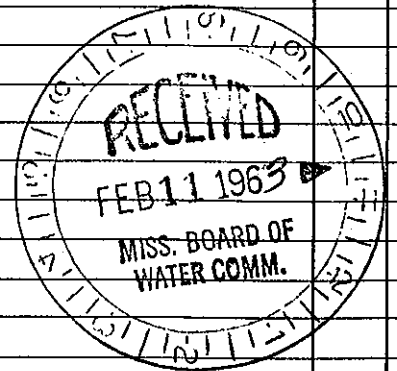

REEVES WELL & PUMP CO.  
 P. O. BOX 71 - PHONE 684-1451  
 McCOMB, MISS.

(Use Back Side)

Well No.

Mail this copy to Board of Water Commissioners 429 Miss. St. Jackson, Miss.