

Amite  
K8  
8-66

MISSISSIPPI BOARD OF WATER COMMISSIONERS

WATER WELL DRILLERS LOG

CODED

Date: Aug 2, 1966, Driller: Sevens Well Pump County: Orleans  
(When well drilled) (Name) (Where well is located)

(1) Owner of Land	Description & Color of Materials Sand, Clay, Red Clay, Shell, etc.	Thick- ness Feet	Depth Feet
<u>E. L. Laperriere</u> (Name) <u>RTD, Liberty-</u> (Address)	<u>Red Clay</u>	<u>15</u>	<u>15</u>
(2) Location: <u>1/4</u> , <u>1/4</u> , Sec. <u>34 3 R 6</u>	<u>Red Sand &amp; Gravel</u>	<u>10</u>	<u>25</u>
<u>9</u> miles <u>west</u> of <u>Widow</u> (distance) (direction) (Nearest Town)	<u>white chalk</u>	<u>25</u>	<u>50</u>
(3) Topography: <u>hilly</u> (Hilly) (Flat) (Level)	<u>Red sand &amp; gravel</u>	<u>15</u>	<u>65</u>
(4) Purpose of Well: <u>Domestic</u> (Domestic Irrigation Municipal, Industrial, Other)			

Information upon completion of well:

- (1) Diameter 4 inches.
- (2) Total Depth 65 feet.
- (3) Water Level 37 feet below top of ground.
- (4) Cased to Bottom Size 4"
- (5) Screen: Size 4", Length 6'
- (6) Were any formations sealed against pollution?  
\_\_\_\_\_ yes,  no.

If YES depth of formation \_\_\_\_\_


Why \_\_\_\_\_

Drillers Remarks: \_\_\_\_\_

Yield in gpm: \_\_\_\_\_

Size pump: \_\_\_\_\_

Type power: \_\_\_\_\_

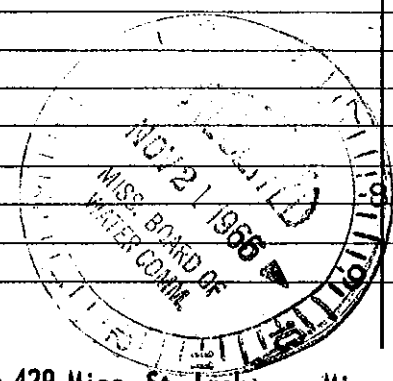

Mail this copy to Board of Water Commissioners 429 Miss. St. Jackson, Miss.