

Amite
169
10-66

MISSISSIPPI BOARD OF WATER COMMISSIONERS

CODED

WATER WELL DRILLERS LOG

Date Nov. 10, 1966, Driller: A. T. Cavington Sen County Amite
(Name)

	Description & Color of Materials Sand, Clay, Red Clay, Shell, etc.	Thick- ness Feet	Depth Feet
(1) Owner of Land: <u>Adman Allen</u> (Name)			
<u>McComb, Miss.</u> (Address)	<u>Clay</u>	<u>25</u>	<u>25</u>
(2) Location: <u>NE 1/4, NE 1/4, Sec. 35 T3 R6</u>	<u>Clay sand</u>	<u>15</u>	<u>40</u>
<u>6</u> miles <u>West</u> of <u>McComb</u> (distance) (direction) (Nearest Town)	<u>Sand</u>	<u>5</u>	<u>45</u>
(3) Topography: <input checked="" type="checkbox"/> (Hilly) <input type="checkbox"/> (Flat) <input type="checkbox"/> (Level)	<u>Grd Rock</u>	<u>11</u>	<u>56</u>
(4) Purpose of Well: <u>Domestic</u> (Domestic Irrigation Municipal, Industrial, Other)			


Information upon completion of well:

- (1) Diameter 4 inches.
- (2) Total Depth 56 feet.
- (3) Water Level 45 feet below top of ground.
- (4) Cased to 56', Size 4"
- (5) Screen: Size 4", Length 6'
- (6) Were any formations sealed against pollution?
_____ yes, no.

If YES depth of formation _____

Why _____

Drillers Remarks: _____

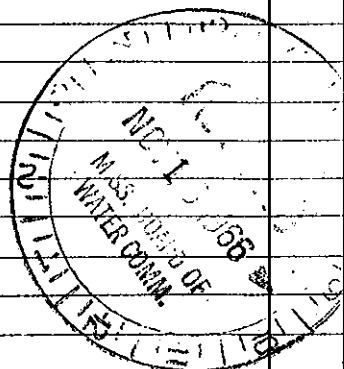

(Use Back Side)

Well No.

This copy to Board of Water Commissioners 429 Miss. St. Jackson, Miss.