

Amite
K12
3-67

MISSISSIPPI
BOARD OF WATER COMMISSIONERS
416 North State Street
Jackson, Mississippi 39201

CODED

WATER WELL DRILLERS LOG

Amite
~~Amite~~

Mar 17 1967 date well completed
Fitzgerald well drill firm name
Amite county well located

LANDOWNER: Wayne Sumner

Rt. Summit, Miss.
(mailing address)

WELL LOCATION:
sec. 5 T. 3 N R. 6 E
+ #
1 miles E of Thompson
(distance) (direction) (nearest town)

description of formations encountered	from	to
Brown clay	0	20
Red sand	20	50
white chalk	50	70
Blue chalk	70	118
Fine sand	118	160
Coarse sand	160	175

WELL PURPOSE: Home
(home, irrigation, municipal, industrial)

WELL COMPLETION DATA:

(1) diameter (inches) 4

(2) total depth (feet) 175

(3) static water level (feet) 40 below above top of ground.

(4) casing Plastic, 16.7,
(material) (depth)
4 if telescope see back.
(size)


(5) screen 8', 16.7
(length) (depth to top)
4", Plastic
(size) (material)

(6) pump 1/2 5
(HP) (yield gpm)
Electric
(type power)

(7) electric log Yes
(yes or no)

(organization running log)

(8) how well bottom plugged Wood plug

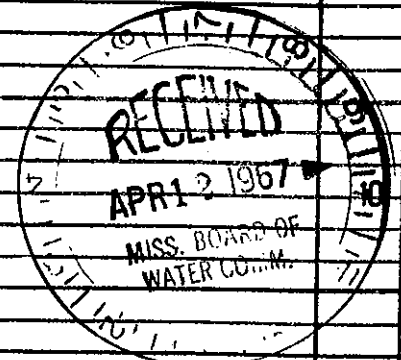

DRILLERS REMARKS: