

CODE:

Amite
K15
4-67

MISSISSIPPI
 BOARD OF WATER COMMISSIONERS
 416 North State Street
 Jackson, Mississippi 39201

WATER WELL DRILLERS LOG

Apr 28 1967 Fitzgibbon & Lusk Amite
 date well completed firm name county well located


LANDOWNER: Hugh Bennet Lusk
Summit Rd 3
McComb Route
 (mailing address)

WELL LOCATION:
 sec 36 T 3 N R 6 E
7 miles SSW of McComb
 (distance) (direction) (nearest town)

WELL PURPOSE: Home
 (home, irrigation, municipal, industrial)

- WELL COMPLETION DATA:
- (1) diameter (inches) 4
 - (2) total depth (feet) 108
 - (3) static water level (feet) 80 below above top of ground.
 - (4) casing Plastic, 108
 (material) (depth)
4 If telescope see back.
 (size)
 - (5) screen 8', 100
 (length) (depth to top)
4", Plastic
 (size) (material)
 - (6) pump ? ?
 (HP) (yield gpm)
Electric
 (type power)
 - (7) electric log No
 (yes or no)
 (organization running log)
 - (8) how well bottom plugged wood plug

description of formations encountered	from	to
Red clay	0	10
Red chert	12	40
Red gravel	40	55
Red sand + gravel	55	80
Red siltstone sand	80	90
Coarse sand + gravel	90	108

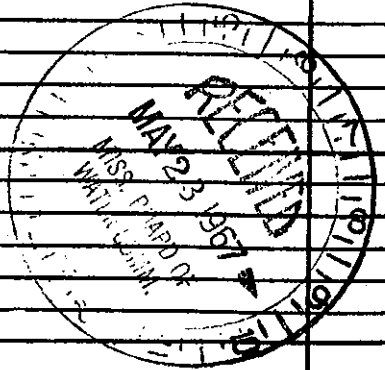

DRILLERS REMARKS: