

Amite
 R18
 8-67

MISSISSIPPI
 BOARD OF WATER COMMISSIONERS
 416 North State Street
 Jackson, Mississippi 39201

CODED

WATER WELL DRILLERS LOG

8-2
 date well completed

1967 Fitzgerald Water Well Amite
 firm name county well located


LANDOWNER: Eric Parker
 601 Burk St
 N Odomb
 (mailing address)

description of formations encountered	from	to
topsoil	0	12
sand	12	60
sand & gravel	60	94
chert	94	

WELL LOCATION:
 sec 24 T 3 N R 6 E
 8 miles West of N Odomb
 (distance) (direction) (nearest town)

WELL PURPOSE: sand
 (home, irrigation, municipal, industrial)

- WELL COMPLETION DATA:
- (1) diameter (inches) 4 9/4
 - (2) total depth (feet) 94
 - (3) static water level (feet) 50 below top of ground
 - (4) casing plastic 80 (material), (depth)
 4 (size) if telescope see back.
 - (5) screen 14' 80 (length), (depth to top)
 4 plastic (size), (material)
 - (6) pump 1/2 HP Sub 35 (type power), (yield gpm)
 - (7) electric log NO (yes or no)
 - (8) how well bottom plugged Wood peg

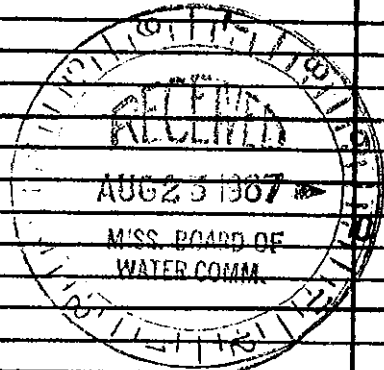

DRILLERS REMARKS: