

AMITE
K20

MISSISSIPPI BOARD OF WATER COMMISSIONERS

3826

6-21-65

WATER WELL DRILLERS LOG

CODED
CODED

Date: 6-21, 1965, Driller: Chester Reems, County: Amite
(Name)

(1) Owner of Land:	Description & Color of Materials Sand, Clay, Red Clay, Shell, etc.	Thick- ness Feet	Depth Feet
L. Temple (Name) RFD #4, Liberty (Address)	Red clay Sand & gravel	10	61
(2) Location: 1/4, 1/4, Sec. 29 T3R6			
10 miles west of M. Lamb (direction) (direction) (Nearest Town)			
(3) Topography: (Hilly) (Flat) (Level)			
(4) Purpose of Well: Domestic (Domestic Irrigation Municipal, Industrial, Other)			

CODED


Information upon completion of well:

- (1) Diameter 4 inches.
- (2) Total Depth 61 feet.
- (3) Water Level 29 feet below top of ground.
- (4) Cased to Bottom Size 4"
- (5) Screen: Size 4", Length 7'
- (6) Were any formations sealed against pollution?
yes, no.

If YES depth of formation _____

Why _____

Drillers Remarks: good well
Bad

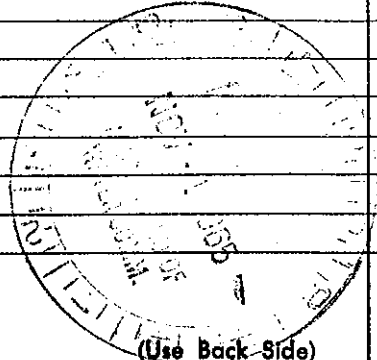

(Use Back Side)

Well No.

Mail this copy to Board of Water Commissioners 429 Miss. St. Jackson, Miss.