

AMITE MISSISSIPPI BOARD OF WATER COMMISSIONERS

K21

3827

9-4-64

WATER WELL DRILLERS LOG

CODED

Date: 9-4, 1964, Driller: Chester Kerns County Amite
(Name)

(1) Owner of Land:	Description & Color of Materials Sand, Clay, Red Clay, Shell, etc.	Thick- ness Feet	Depth Feet
<u>Superior</u> (Name) <u>RT-D. Liberty</u> (Address)	<u>Red clay</u>	<u>10</u>	<u>10</u>
	<u>Red sand & gravel</u>	<u>30</u>	<u>40</u>
(2) Location: $\frac{1}{4}$, $\frac{1}{4}$, Sec. <u>29</u> T <u>3</u> R <u>4</u> <u>10</u> miles <u>west</u> of <u>Madamb</u> (distance) (direction) (Nearest Town)	<u>Small gravel</u>	<u>18</u>	<u>58</u>
(3) Topography: <u>Hilly</u> (Hilly) (Flat) (Level)			
(4) Purpose of Well: <u>Domestic</u> (Domestic Irrigation Municipal, Industrial, Other)			

CODED


Information upon completion of well:

- (1) Diameter 4 inches.
- (2) Total Depth 58 feet.
- (3) Water Level 40 feet below top of ground.
- (4) Cased to Bottom Size 4"
- (5) Screen: Size 4", Length 6'
- (6) Were any formations sealed against pollution?
_____ yes, no.

If YES depth of formation _____

Why _____

Drillers Remarks: old well
Contaminated

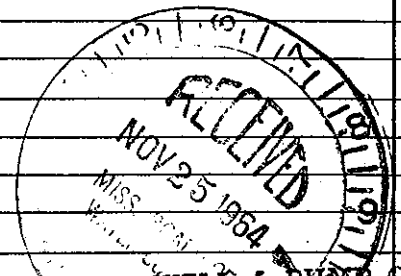

REEVES WELLS & PUMP CO.
P. O. BOX 71 -- PHONE 684-1451
McCOMB, MISS.

Well No.

(Use Back Side)

Mail this copy to Board of Water Commissioners 429 Miss. St. Jackson, Miss.