

~~PKR~~

MISSISSIPPI BOARD OF WATER COMMISSIONERS

Completed
12/5/68
J. T. Covington

3-15-66

ANN E

WATER WELL DRILLERS LOG

CODED


ANN E

Date: 3-15, 1966, Driller: J. T. Covington, County: Pike

(Name)

		Description & Color of Materials Sand, Clay, Red Clay, Shell, etc.	Thick- ness Feet	Depth Feet
(1) Owner of Land:	George Martin (Name)	Sandy Clay	10	10
	M'Comb Mississippi (Address)	Red clay	20	30
(2) Location:	NW 1/4, SW 1/4, Sec. 36 T. 3 R. 6 E	Sand + Chalk	20	60
	5 miles west of M'Comb (distance) (direction) (Nearest Town)	Sand + Rock	23	83
(3) Topography:	Hilly (Hilly) (Flat) (Level)			
(4) Purpose of Well:	 (Domestic Irrigation Municipal, Industrial, Other)			
Information upon completion of well:				
(1) Diameter	4" inches.			
(2) Total Depth	83' feet.			
(3) Water Level	70' feet below top of ground.			
(4) Cased to	83', Size 4"			
(5) Screen: Size	4", Length 6'			
(6) Were any formations sealed against pollution?	yes, <input checked="" type="checkbox"/> no.			
If YES depth of formation				
Why				
Drillers Remarks:				

~~Cannot locate.
may be R 6 E.
RM~~

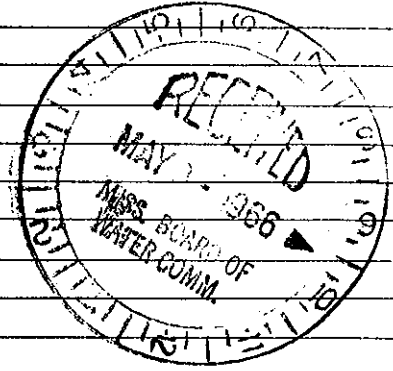

(Use Back Side)

Well No.

Mail this copy to Board of Water Commissioners 429 Miss. St. Jackson, Miss