

AMITE
K58
11-29-73

MISSISSIPPI
BOARD OF WATER COMMISSIONERS
416 North State Street
Jackson, Mississippi 39201 CODED

WATER WELL DRILLERS LOG

Nov 29 1973 chester keener amite
date well completed firm name county well located

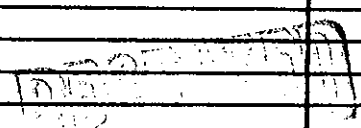
LANDOWNER	description of formations encountered	from	to
Wesley Brown	clay	@ 12	
H. L. Bagn, Magnolia (mailing address)	Sand	12	35
	small gravel sand	35	60

WELL LOCATION:
sec. 33 T. 3 N R. 6 E
12 miles ENE of Liberty
(distance) (direction) (nearest town)

WELL PURPOSE: Home
(home, irrigation, municipal, industrial)

- WELL COMPLETION DATA:
- (1) diameter (inches) 4"
 - (2) total depth (feet)
 - (3) static water level (feet) 20 below top of ground.
 - (4) casing (material) Rust Bottom (depth)
 - (size) If telescope see back.
 - (5) screen 6' 54' (length) (depth to top)
 - (size) 4" (material) Rust
 - (6) pump Byathers (HP) (yield gpm)
 - (type power) elect
 - (7) electric log NO (yes or no)
 - (organization running log)
 - (8) how well bottom plugged wood plug

DRILLERS REMARKS:
old well plugged
sand

CODED
 MAY 24 1974 MISS. BD. OF WATER COMMISSIONERS