

AMITE
K60
8-13-74

MISSISSIPPI
BOARD OF WATER COMMISSIONERS
416 North State Street
Jackson, Mississippi 39201

CODED

WATER WELL DRILLERS LOG

13 Aug 1974 J.T. Covington Amite
date well completed firm name county well located


LANDOWNER: W.B. Breckenridge
Liberty
(mailing address)

description of formations encountered	from	to
clay	0	20
sh. clay	20	42
Sand	42	123

WELL LOCATION:
sec. 10 T. 3 N R. 6 E
5 miles W of N. Columbus
(distance) (direction) (nearest town)

WELL PURPOSE:
(home, irrigation, municipal, industrial)

- WELL COMPLETION DATA:
- (1) diameter (inches) 4
 - (2) total depth (feet) 123
 - (3) static water level (feet) 75 below top of ground
 - (4) casing (material) 117 (depth)
 - (size) If telescope see back.
 - (5) screen (length) 6 (depth to top) 117
 - (size) 4 (material) 117
 - (6) pump 1/2 (HP) 8 (yield gpm)
 - (type power) split
 - (7) electric log (yes or no)
 - (organization running log)
 - (8) how well bottom plugged wood

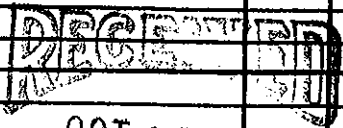

DRILLERS REMARKS:

MISS. BD. OF WATER COMM.