State Well Report	
County: <u>Hen-te</u> Part 1	For Office Use Only:
Permit #: Mississippi Department of Environmental	Quality Aquifer:
Driller: FlorerAld hett Server, anc. P.O. Box 10631	s Well #: <u>K - 91</u>
	L. S. Elevation:
Date drilling completed: $12 - 10 - 04$ (601)961-5210	
(601)354-6938 (fax)	E-log #:
State Law requires that this report be prepared by the driller in detail an 30 days of completion of drilling of the small	d filed with the Department within
30 days of completion of drilling of the well. Well Owner Information	
	Well Location
Owner Name_BAL Netfless Latitude:	''' Longitude:'''
Mailing All R Tray Al	(circle one): Conventional Survey,
USGS quad, H	Hand-held GPS, Survey-grade GPS
	Sec. <u>24</u> Twn <u>3N</u> Rng GE
City State Zip Code 44 S	ec Z Twn JN Rng OF
Distance Di	rection Nearest Town eff_ofor
Well Data	
Purpose of Well (circle one) Home Industrial Public Supply Irrigation Fish C	
The second work (effect one) Home industrial Public Supply Irrigation Fish C	ulture Other: Poulty (touse)
Date well drilling started: $12 - 10 - 04$ , Date well drilling completed	12-10-04-
If flowing, method of flow regulation: Valve Other (describe)	
Static Water Level:feet above or below (circle one) land surface Date m	easured: 12-10-04
	er:
Hole depth: Well depth: Well grouted to a d	lepth of 10 feet
Type of grout (circle one): Cement Bentonite Mix	
Contraction of March	0
incluse Type of S	screen: <u>P/C</u>
Screen slot size: inches Setting depth: From feet	tofeet
Type of completion (circle all applicable): Gravel packed Underreamed Telescoped	Open hole Natural Development
Other (describe):	
Top of lap pipe or reduction in casing:feet. If telescoped or more than	
Logs run (circle all applicable): No log run Electric Gamma Ray Density Sonic No	
Name of organization running log(s)	
I certify that the well was drilled, constructed, and completed in accordance with all ap	plicable requirements of the Mississinni
Department of Environmental Quality and/or the Mississippi Department of Health reg	ulations and state laws.
BIAJ F-tzgerald age Brac	Strend
Print Name of Water Well Contractor and License No. Sig	nature of Water Well Contractor
	RECEIVER
	DEC 2 2 2004


BY: OLWR

If well telescopes please sketch below and show depths.



	·	Description of Formations Encountered	From	То
		Clay	0	20
		San dr	20	60
		granet	60	80
		Cluy	80	90
		<u> </u>	90	100
•		course sandterent	100	120
		·······		_
	·			
				<b>_</b>
		· · · · · · · · · · · · · · · · · · ·	<u> </u>	
				<u> </u>
				<u> </u>
	<u> </u>	······································		<u> </u>
				<u> </u>
		·····		
			_	+
		·		
			_	<b>_</b>
	L			<u> </u>

If more than one screen, show location of each on sketch

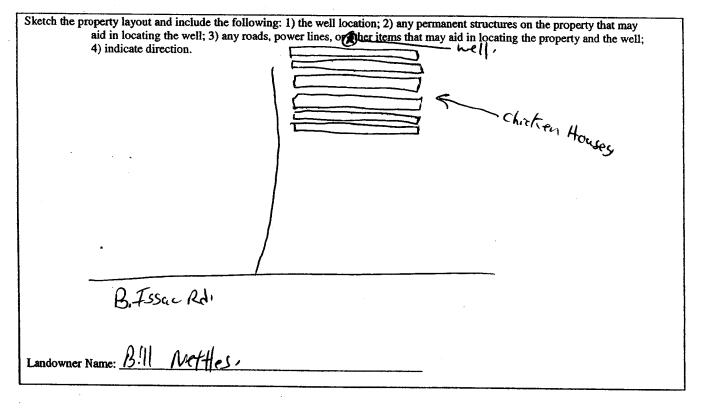

Signature of Waler Well Contractor

DEC 2 2 2004 BY: OLWR

## K.91

A 1	7	LL REPORT		
County: Mite.	Pump Installer's Completion Report Mississippi Department of Environmental Quality Office of Land and Water Resources		For Office Use Only	
Permit #:			Aquifer:	
Driller: FitzgerAld WellSentp	P.O. B	ox 10631	Well #: <u><u></u><u></u><u></u><u></u><u></u><u></u><u></u><u></u><u></u><u></u><u></u><u></u><u></u><u></u><u></u><u></u><u></u><u></u><u></u></u>	
Date completed: 12-19-04		S 39289-0631 061-5210	Well #: <u><u><u></u><u></u><u></u><u></u><u></u><u></u><u></u><u></u><u></u><u></u><u></u><u></u><u></u><u></u><u></u><u></u><u></u><u></u></u></u>	
2 au compress 0		-6938 (fax)	Elevation:	
This report should be prepared by th installation of pump.	e pump installer in detail	and filed with the Depar	tment within 30 days of the	
Well Owner Informat	tion	······	Well Location	
Owner Name: Bill Mettles,		Latitude:	Longitude	
Mailing Address: B. ISSAC Rd.		Latitude: Longitude:		
		Method of Lat/Long (circl	le one): Conventional Survey,	
		USGS quad, I	Hand-held GPS, Survey-grade G	
Summet MS.			24 Twn 31 Rng 66	
City State				
		Distance Directio		
Telephone No. ()		5 Miles hest	of Milomby	
	l			
Pump Type Circle one		· · ·	Power Type	
			Circle one	
Air Lift Jet (	Submersible	Diesel Engine Ga	soline Engine Natural	
Bucket Piston	Turbine	Electric Motor Ha	and Tractor I	
Centrifugal Rotary	Flowing Well	Windmill Ot	her (specify):	
Other (specify):	-			
			otor: <u>3</u>	
Date Pump Installed:		Setting Depth:	feet	
Rated Pump Capacity:35	Gallons Per Minute	Number of Stages:		
Pump Test Data		Method of	Measuring Water Level	
Date Well Tested:			Circle one	
Static Water Level (A):Feet	Below Land Surface	Air Line Electric	Measuring Line Steel Tap	
		Other (specify):		
Pumping Water Level (B):Feet 1	DOLOW LALIC SULLACE	· .		
Drawdown [(B) - (A)]:Feet	Below Land Surface	For flowing well, measure	d shut in head:f	
Test Pumping Rate:			GPM with a drawdown of	
Duration of Pump Test (minimum 4 hours):				
	hours	feet aft	erhours of pump	
			· · · · · · · · · · · · · · · · · · ·	
I HEREBY CERTIFY that the above statem	ents are true to the best of	my knowledge.		
-				
	024.	Blod Street	BECEI	

м. с. и

٠

BY: OLWR