
	State Wel	l Report	·
County: Amote		-	For Office Use Only:
	Part 1 – Driller's Log Mississippi Department of Environmental Quality		Aquifer:
Permit #:	Office of Land and Water Pasouroas		Well #: K-98
Driller: F.tzgerald Well Jara	P.O. Box	10631	Well #:
3-22 -	Jackson, MS 39289-0631		L. S. Elevation:
Date drilling completed: 3-27-06.	(601)96		
	(601)354-6	938 (fax)	E-log #:
State Law requires that this repor Department at the above address	t be prepared by the licens within 30 days of complete	e holder responsible for a	the work and filed with the
Information on Well O			rehole Location
(Landowner if borehole is not fo	-		
Owner Name Tanes Tuplor,	L	atitude:°'	_" Longitude:'"
Mailing Address: Tungipa	ha	lethod of Lat/Long (circle or	ne): Conventional Survey,
Manning Address. <u>14015 pct</u>	10	USGS quad, Hand-heid	GPS, Survey-grade GPS
8. I A		1/4 Sec_ 2	Twn <u>3N Rng GE</u>
Summit M City State			
Telephone No. ()		istance Direction Miles	of milemb
-	Well / Borehold		
Date drilling started: 3-2 7-06 Date dril	lling completed: 327-06	Hole depth: 80-	Hole diameter: 8-11
Location of the source of any surface water Method of dosing and volume of Chlorine	r used for drilling: used in drilling and developm	nent:	
Logs run (circle all applicable); No log run Name of organization running log(s)	Electric Gamma Ray D	ensity Sonic Neutron	Other:
Purpose of borehole (check one): Water We	ellGeotechnical/Geologic	al Investigation Ground	Source Heat Pump
Seismic S If drilling is not related t	urveyOther (<i>describe</i>) to water_well construction, sl	in the remainder of this bla	
Purpose of Well (check one): Home In			Other: 10ul tay 14uuga
If a flowing well, method of flow regulation			2-70
Static Water Level: <u>29</u> feet abo		surface Date measured:	5-21-06
Method of Measurement (circle one)			
Well depth: <u>80</u> Well grouted to a dep	th of <u>/0</u> feet Type of g	rout (circle one) Neat Ceme	ent Bentonite Mix
Casing length: <u>20</u> feet Casing	g diameter: <u>Y"</u> ind	thes Type of casing:	ac
Screen length: 10 ⁻ feet Screen	n diameter: <u>Y</u> in in	ches Type of screen:	Ac
Screen slot size: <u>1012</u> inches	Setting depth: From	feet to	SOfeet
Type of completion (circle all applicable):	Gravel packed Underream	ed Telescoped Open h	ole Natural Development
	Other (describe):		
Top of lap pipe or reduction in casing:			
			Form: OLWR-SWR-1A
			COULT OF AAL-SAAK-14

, ² ~, •

APR 2 6 2006 BY: OLWR

K- 98


The sketch below only required for water wells

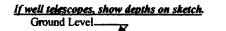

Description of formations encountered must be provided for all wells and boreholes, unless specifically exempted by regulations

From (depth)	To (depth)
Ground Level	
0	20
20	40
40	50
50	70
20	80
	-
+	
+	
<u>+</u>	+
+	
	1
1	
1	
<u>+</u>	+
+	+
	Ground Level

If more than one screen, show location of each on sketch

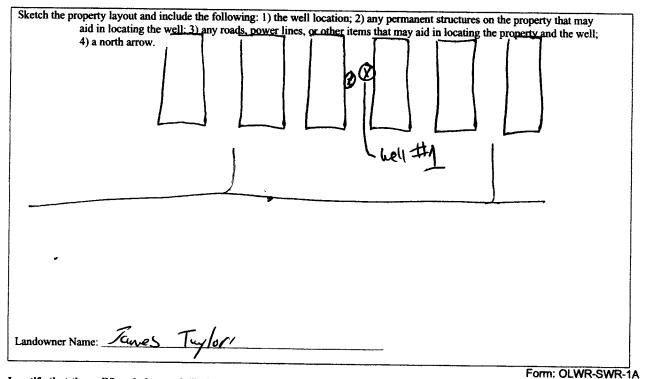

I certify that the well/borehole was drilled, constructed, and completed in accordance with all applicable requirements of the Mississippi Department of Environmental Quality and the Mississippi Department of Health regulations, if applicable, and state

laws BIAd Filzyeald 029, 327-06 Bulf Date

Print Name of Responsible Licensee and License No.

Signature of Licensee

RECEIVED APR 2 6 2006 BY: OLWR

Rump set by the wavehouse.

Permit #	Part 2 Pump Installer's Completion Report Mississippi Department of Environmental Quality Office of Land and Water Resources P.O. Box 10631 Jackson, MS 39289-0631 (601)961-5210	For Office Use Only: Aquifer Well #:	
Date completed <u>3-79-00</u>	(601)354-6938 (fax) ne pump installer in detail and filed with the Depart	Elevation.	
installation of pump. Well Owner Informat		Well Location	
war Name James Tagle	Latitude:	Longitude:	
Tangaddress Tangapy		e one): Conventional Survey Hand-held GPS: Survey-grade GPS	
Summi T, M	27 9 166 1/4 1/4 Sec.	2 Twn 31 Rng 6E	
Slephone No. 4	Distance Direction		
Pump Type Circle one		Power Type Circle one	
an tair Jet	Submersible Diesel Engine Ga	soline Engine Natural Gas	
Rocket Piston	Turbine Electric Motor Ha	and Tractor PTO	
Centrifugal Rotary Other specify: Date Pump Installed: 5–20–00 Pated Pump Capacity: 50	Horse Power Rating of M	ther (specify): lotor:	
Pump Test Data	Method of	f Measuring Water Level Circle one	
Pumping Water Level (B): 72 Feel	Air Line Electric Air Below Land Surface t Below Land Surface	Measuring Line Steel Tape	
· · · · · · · · · · · · · · · · · · ·		ced shut in head: feet	
Test Pumping Rate:		GPM with a drawdown of fterhours of pumping	
Duration of Pump Test (minimum 4 hours) HEREBY CERTIFY that the above state	iments are true to the best of my knowledge.		
Print Name of Pump Installer and License	No. (if applicable) Signature of Pur	mp Installer	

JUN 0 2 2006 BY: OLWR