

State Well Report

Part 1 - Driller's Log

Mississippi Department of Environmental Quality
Office of Land and Water Resources
P.O. Box 2309
Jackson, MS 39225
(601)961- 5210
(601)961- 5228 (fax)

County: Amite
Permit #: _____
Driller: Fitzgerald Well Services
Date drilling completed: 4-19-11

For Office Use Only:
Aquifer: K 125
Well #: _____
L. S. Elevation: _____
E-log #: _____

State Law requires that this report be prepared by the license holder responsible for the work and filed with the Department at the above address within 30 days of completion of drilling of the well or borehole.

Information on Well Owner (Landowner if borehole is not for a water well)	Well or Borehole Location
Owner Name: <u>James Dickerson</u>	Latitude: <u>31° 14' 35.3"</u> Longitude: <u>90° 34' 18.9"</u>
Mailing Address: <u>Copper Gladding Rd</u>	Method of Lat/Long (circle one): Conventional Survey, USGS quad, Hand-held GPS, Survey-grade GPS
<u>Smithdale MS</u>	<u>SW 1/4 NE 1/4 Sec 14 Twn 3N Rng 6E</u>
City State Zip Code	Distance Direction Nearest Town
Telephone No. ()	Miles of

Well / Borehole Data

Date drilling started: 4-19-11 Date drilling completed: 4-19-11 Hole depth: 106' Hole diameter: 8"

Location of the source of any surface water used for drilling: _____
Method of dosing and volume of Chlorine used in drilling and development: _____

Logs run (circle all applicable): No log run Electric Gamma Ray Density Sonic Neutron Other: _____
Name of organization running log(s): _____

Purpose of borehole (check one): Water Well Geotechnical/Geological Investigation _____ Ground Source Heat Pump _____
Seismic Survey _____ Other (describe) _____

If drilling is not related to water well construction, skip the remainder of this block

Purpose of Well (check one): Home Industrial _____ Public Supply _____ Irrigation _____ Fish Culture _____ Other: Poultry House

If a flowing well, method of flow regulation: Valve _____ Other (describe) _____

Static Water Level: 32' feet above or below (circle one) land surface Date measured: 4-19-11

Method of Measurement (circle one) steel tape electric tape air line other: _____

Well depth: 106' Well grouted to a depth of 10' feet Type of grout (circle one): Neat Cement Bentonite Mix

Casing length: 90' feet Casing diameter: 4" inches Type of casing: PVC

Screen length: 16' feet Screen diameter: 4" inches Type of screen: PVC

Screen slot size: 0.10/0.12 - 10" inches Setting depth: From 90' feet to 106' feet

Type of completion (circle all applicable): Gravel packed Underreamed Telescoped Open hole Natural Development
Other (describe): _____

Top of lap pipe or reduction in casing: _____ feet. *If telescoped or more than one screen, describe on next page*

Well completed 4-26-11

Form: OLWR-SWR-1A (04/08)


RECEIVED
MAY 20 2011
BY: OLWR

K125

The sketch below only required for water wells

If well telescopes, show depths on sketch.

Ground Level →

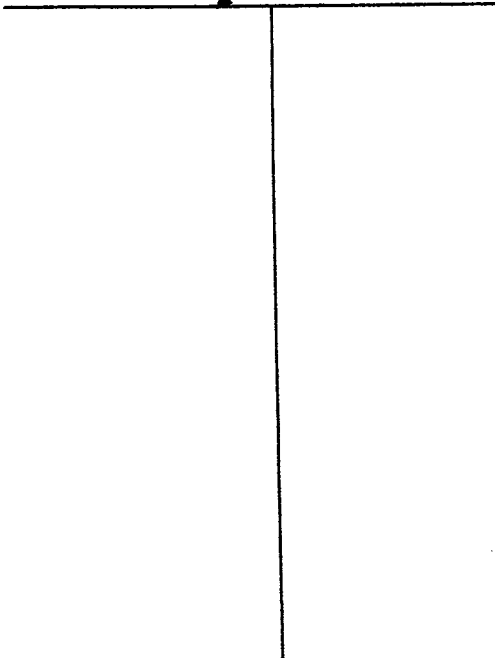


Description of formations encountered must be provided for all wells and boreholes, unless specifically exempted by regulations

Description of Formations Encountered	From (depth)	To (depth)
	Ground Level	
Clay	0	20
Sand	20	60
Gravel	60	80
Sand	80	90
Coarse Sand	90	100

If more than one screen, show location of each on sketch

Sketch the property layout and include the following: 1) the well location; 2) any permanent structures on the property that may aid in locating the well; 3) any roads, power lines, or other items that may aid in locating the property and the well; 4) a north arrow.

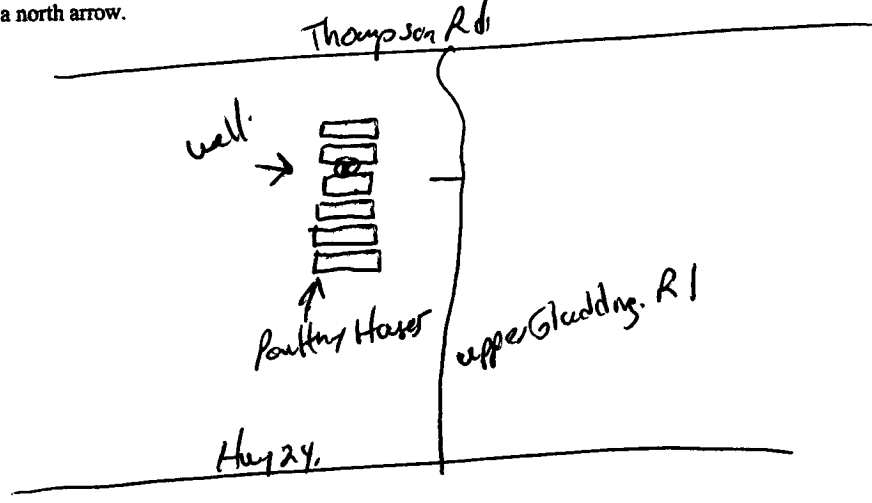

Landowner Name: James DeKason

Form: OLWR-SWR-1A (04/08)

I certify that the well/borehole was drilled, constructed, and completed in accordance with all applicable requirements of the Mississippi Department of Environmental Quality and the Mississippi Department of Health regulations, if applicable, and state laws.

Brad Fitzgerald 029 4-19-11 [Signature] Signature of Licensee

RECEIVED
MAY 20 2011
BY: OLWR

STATE WELL REPORT

Part 2

Pump Installer's Completion Report
 Mississippi Department of Environmental Quality
 Office of Land and Water Resources
 P.O. Box 2309
 Jackson, MS 39225
 (601)961-5210
 (601)961-5228 (fax)

For Office Use Only:

Aquifer: _____
 Well #: _____
 Elevation: _____

County: Amite
 Permit #: _____
 Driller: Fitzgerald Well Service
 Date completed: 4-19-11
Copy information from block on Part 1

This part of the report must be completed by a licensed water well contractor or a licensed pump installer. A copy of Part 1 of the report must be attached and both parts filed with the Department at the above address within 30 days of well completion.

Well Owner Information	Well Location
Owner Name: <u>James Dickerson</u>	Latitude: <u>30° 14' 35.3"</u> Longitude: <u>90° 34' 18.9"</u>
Mailing Address: <u>upper Gladding Rd.</u>	Method of Lat/Long (check one): Conventional Survey _____
<u>Southdale ms.</u>	USGS quad _____, Hand-held GPS _____, Survey-grade GPS _____
City State Zip Code	_____ 1/4 _____ 1/4 Sec <u>14</u> T <u>3N</u> R <u>6E</u>
Telephone No. () _____	Distance _____ Direction _____ Nearest Town _____
	_____ Miles _____ of _____

Pump Type	Power Type
Circle one	Circle one
Air Lift <input type="checkbox"/> Jet <input type="checkbox"/> <u>Submersible</u>	Diesel Engine <input type="checkbox"/> Gasoline Engine <input type="checkbox"/> Natural Gas <input type="checkbox"/>
Bucket <input type="checkbox"/> Piston <input type="checkbox"/> Turbine <input type="checkbox"/>	<u>Electric Motor</u> <input type="checkbox"/> Hand <input type="checkbox"/> Tractor PTO <input type="checkbox"/>
Centrifugal <input type="checkbox"/> Rotary <input type="checkbox"/> Flowing Well <input type="checkbox"/>	Windmill <input type="checkbox"/> Other (specify): _____
Other (specify): _____	Horse Power Rating of Motor: <u>2</u>
Date Pump Installed: <u>4-26-11</u>	Setting Depth: <u>80</u> feet
Rated Pump Capacity: <u>33</u> Gallons Per Minute	Number of Stages: <u>?</u>

Pump Test Data	Method of Measuring Water Level
Date Well Tested: _____	Circle one
Static Water Level (A): _____ Feet Below Land Surface	Air Line <input type="checkbox"/> Electric Measuring Line <input type="checkbox"/> <u>Steel Tape</u>
Pumping Water Level (B): _____ Feet Below Land Surface	Other (specify): _____
Drawdown [(B) - (A)]: _____ Feet Below Land Surface	For flowing well, measured shut in head: _____ feet
Test Pumping Rate: _____ Gallons Per Minute	Well yielded _____ GPM with a drawdown of _____ feet after _____ hours of pumping
Duration of Pump Test (minimum 4 hours): _____ hours	

This is for (circle one): New Well Replacement of Existing Pump Repair of Existing Pump

I HEREBY CERTIFY that the above statements are true to the best of my knowledge.
Brad Fitzgerald 029. Paul Hild
 Print Name of Pump Installer and License No. (if applicable) Signature of Pump Installer

Form: OLWR-SWR-1C (07-09)

Pump set 4-26-11

RECEIVED

MAY 20 2011

BY: OLWR