

AMITE MISSISSIPPI BOARD OF WATER COMMISSIONERS

WATER WELL DRILLERS LOG

Date: 7-31, 1962 Driller: Chester Reeves County Amite

(Name)

(1) Owner of Land (Name)	Description & Color of Materials Sand, Clay, Red Clay, Shell, etc.	Thick- ness Feet	Depth Feet
<u>J. E. Priest -</u> <u>Baton Rouge, La -</u> (Address)	<u>sandy clay</u>	<u>10</u>	<u>10</u>
(2) Location: <u>1/4</u> , <u>1/4</u> , Sec. <u>3</u> T <u>2</u> R <u>2</u>	<u>sand & gravel</u>	<u>8</u>	<u>18</u>
<u>5</u> miles <u>S.E.</u> of <u>Gloster</u> (distance) (direction) (Nearest Town)	<u>blue clay</u>	<u>12</u>	<u>30</u>
(3) Topography: <u>Flat</u> (Hilly) (Flat) (Level)	<u>fine sand</u>	<u>15</u>	<u>45</u>
(4) Purpose of Well: <u>Domestic</u> (Domestic Irrigation Municipal, Industrial, Other)	<u>small pe gravel</u>	<u>5</u>	<u>50</u>

Information upon completion of well:


- (1) Diameter 4 inches.
- (2) Total Depth 50 feet.
- (3) Water Level 15 feet below top of ground.
- (4) Cased to Bottom Size 4'
- (5) Screen: Size 4", Length 4'
- (6) Were any formations sealed against pollution?
 yes, no.

If YES depth of formation _____

Why _____

Drillers Remarks: New location

No previous well

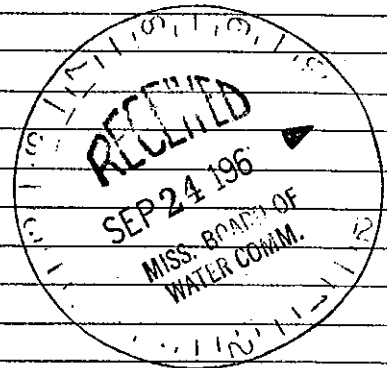

REEVES WELL AND PUMP CO.
Phone 1250
McCOMB, MISSISSIPPI

(Use Back Side)

Well No.

Mail this copy to Board of Water Commissioners 429 Miss. St. Jackson, Miss