

Amite  
L3  
9-66

MISSISSIPPI BOARD OF WATER COMMISSIONERS

CODED

WATER WELL DRILLERS LOG

Date: 9-8-66, 1966, Driller: A. Fitzmaurice County Amite  
(When well drilled) (Name) (Where well is located)

(1) Owner of Land: Edmund Ray  
(Name)

(2) Location: SW 1/4, NW 1/4, Sec. 21, T. 22, R. 10E  
4 1/2 miles N of Amite  
(distance) (direction) (Nearest Town)

(3) Topography: Hilly  
(Hilly) (Flat) (Level)

(4) Purpose of Well: Domestic  
(Domestic Irrigation, Municipal, Industrial, Other)

| Description & Color of Materials<br>Sand, Clay, Red Clay, Shell, etc. | Thick-<br>ness<br>Feet | Depth<br>Feet |
|---|------------------------|---------------|
| <u>Topsoil &amp; clay</u>   | <u>25</u>              | <u>25</u>     |
| <u>Red sand</u>   | <u>45</u>              | <u>70</u>     |
| <u>Red sand topsoil</u>   | <u>18</u>              | <u>88</u>     |
| <u>Red clay</u>   | <u>22</u>              | <u>110</u>    |
| <u>Mud in base</u>  | <u>30</u>              | <u>140</u>    |

Information upon completion of well:

(1) Diameter 4 inches.

(2) Total Depth 140 feet.

(3) Water Level 100 feet below top of ground.

(4) Cased to 132, Size 4

(5) Screen: Size 4, Length 8'

(6) Were any formations sealed against pollution?  
\_\_\_\_\_ yes,  no.

If YES depth of formation \_\_\_\_\_


Why \_\_\_\_\_

Drillers Remarks: \_\_\_\_\_

Yield in gpm: \_\_\_\_\_

Size pump: \_\_\_\_\_

Type power: Elec

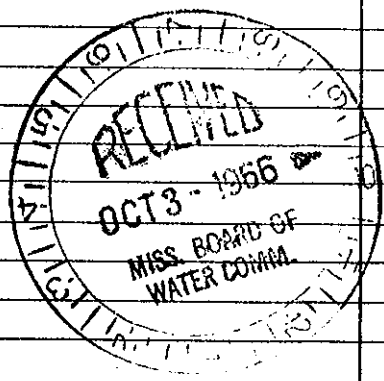

Mail this copy to Board of Water Commissioners 429 Miss. St. Jackson, Miss.