

AMITE MISSISSIPPI BOARD OF WATER COMMISSIONERS

L5  
9-15-64

1663 WATER WELL DRILLERS LOG

**CODED**

Date: 9-15, 1964, Driller: Chester Reeves County, Amite

(Name)

(1) Owner of Land:	Description & Color of Materials Sand, Clay, Red Clay, Shell, etc.	Thick- ness Feet	Depth Feet
C. J. Myfield (Name) Centerville, MS (Address)	yellow clay yellow sand & gravel	22	22
(2) Location: 1/4, 1/4, Sec. 41 T2R2, 5 miles east of Centerville (distance) (direction) (Nearest Town)	gravel	28	50
(3) Topography: Kelly (Hilly) (Flat) (Level)	blue clay	8	58
(4) Purpose of Well: Domestic (Domestic Irrigation Municipal, Industrial, Other)	sand & gravel	57	115
		19	134

Information upon completion of well:


- (1) Diameter 4 inches.
- (2) Total Depth 134 feet.
- (3) Water Level 70 feet below top of ground.
- (4) Cased to bottom, Size 4"
- (5) Screen: Size 4", Length 7'
- (6) Were any formations sealed against pollution?  
yes,  no.

If YES depth of formation \_\_\_\_\_

Why \_\_\_\_\_

Drillers Remarks: add well  
insufficient

**CODED**

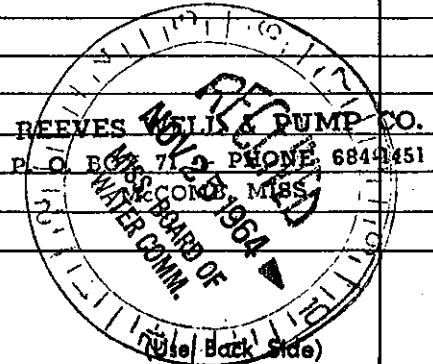

Well No.

Mail this copy to Board of Water Commissioners 429 Miss. St. Jackson, Miss.