

ANITE

MISSISSIPPI BOARD OF WATER COMMISSIONERS

L 6

1587

4-21-65 WATER WELL DRILLERS LOG

CODED

Date: 4-21, 1965, Driller: Chester Reeves County Amite

(Name)

(1) Owner of Land	Description & Color of Materials Sand, Clay, Red Clay, Shell, etc.	Thick- ness Feet	Depth Feet
Murray Owens Jr. (Name) RFD Centerville (Address)	Surface clay	12	12
	Sand	35	50
	White chalk	16	176
(2) Location: 1/4, 1/4, Sec. 27, T2R2 2 1/2 miles NE Centerville (Distance) (Direction) (Nearest Town) ON Highway 74	Sand & gravel	12	158
(3) Topography: Hilly (Hilly) (Flat) (Level)	Blue chalk	82	240
(4) Purpose of Well: Domestic (Domestic Irrigation Municipal, Industrial, Other)	Coarse sand	20	260

Information upon completion of well:


- (1) Diameter 2 inches.
- (2) Total Depth 260 feet.
- (3) Water Level 150 feet below top of ground.
- (4) Cased to Bottom, Size 2"
- (5) Screen: Size 2", Length 5'
- (6) Were any formations sealed against pollution?  
yes,  no.

If YES depth of formation \_\_\_\_\_

Why \_\_\_\_\_

Drillers Remarks: New House Location

CODED

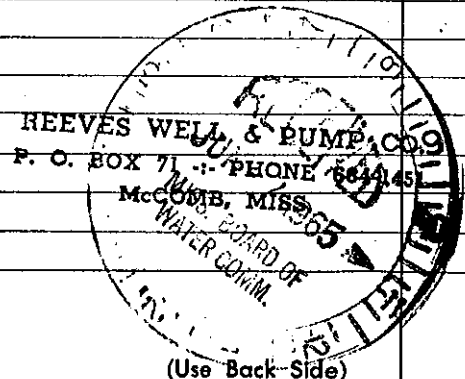

(Use Back Side)

Well No.

Mail this copy to Board of Water Commissioners 429 Miss. St. Jackson, Miss.