

CODED

AMITE
L7
4-13-66

MISSISSIPPI BOARD OF WATER COMMISSIONERS

2056
WATER WELL DRILLERS LOG

Date: 4-13, 1966, Driller: Chester Kern County Amite
(When well drilled) (Name) (Where well is located)

(1) Owner of Land: Beacham Williams
(Name)
RFD Glaster
(Address)
(2) Location: 1/4, 1/4, Sec. 4 T2R2
4 miles S.E. of Glaster
(distance) (direction) (Nearest Town)
(3) Topography: Hilly
(Hilly) (Flat) (Level)
(4) Purpose of Well: Domestic
(Domestic Irrigation
Municipal, Industrial, Other)


Description & Color of Materials Sand, Clay, Red Clay, Shell, etc.	Thick- ness Feet	Depth Feet
<u>Clay</u>	<u>20</u>	<u>20</u>
<u>Red Sand</u>	<u>40</u>	<u>60</u>
<u>Gravel</u>	<u>15</u>	<u>75</u>
<u>Sandy sand mixed with small amount of gravel</u>		<u>47117</u>

Information upon completion of well:

- (1) Diameter 4 inches.
- (2) Total Depth 117 feet.
- (3) Water Level 20 feet below top of ground.
- (4) Cased to Ballou size 4"
- (5) Screen: Size 4', Length 6'
- (6) Were any formations sealed against pollution?
yes, no.

If YES depth of formation _____
Why _____
Drillers Remarks: Newhouse
Yield in gpm: 12
Size pump: 5 HP Sub
Type power: Electric

CODED

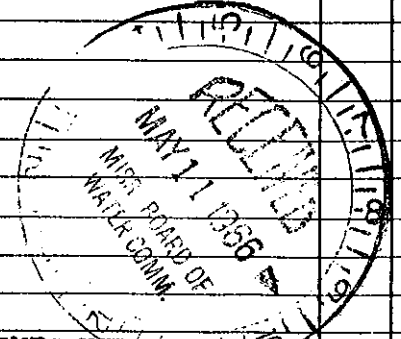

REEVES WELL & PUMP CO.
P. O. BOX 71 - PHONE 884-1451
McCOMB, MISS.

Mail this copy to Board of Water Commissioners 429 Miss. St. Jackson, Miss.