

AMITE
L8
2-68

MISSISSIPPI
BOARD OF WATER COMMISSIONERS
416 North State Street
Jackson, Mississippi 39201

WATER WELL DRILLERS LOG

Feb 17 1968 *68 Reeves well Memphis* Amite
date well completed film name county well located


LANDOWNER: *W. L. ...*
Fidelity National Bank
Baton Rouge, La.
(mailing address)

WELL LOCATION:
sec *R* T *2* N R *2* E *Block*
4 miles *South* of *...*
(distance) (direction) (nearest town)

WELL PURPOSE: *Domestic*
(home, irrigation, municipal, industrial)

- WELL COMPLETION DATA:
- (1) diameter (inches) 4"
 - (2) total depth (feet) 110
 - (3) static water level (feet) 57 below above top of ground
 - (4) casing Plastic Balloon
(material) (depth)
(size) if telescope see back.
 - (5) screen 6' 104
(length) (depth to top)
4" Plastic
(size) (material)
 - (6) pump 3/4 HP 15
(HP) (yield gpm)
elect
(type power)
 - (7) electric log no
(yes or no)
 - (organization running log)
 - (8) how well bottom plugged slugs wooden

description of formations encountered	from	to
Red clay gravel & sand	0	27
Red sand & chalk	27	63
gravel	63	70
pink chalk	70	90
clean coarse sand & pea gravel	90	110
white chalk underneath		

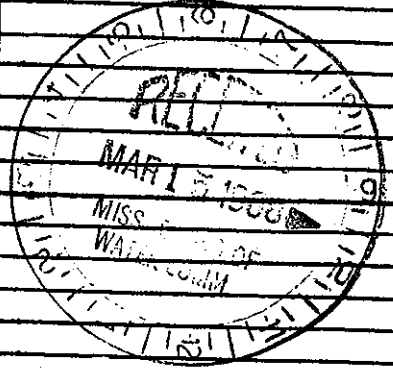

DRILLERS REMARKS:
old well
bad