

AMITE
L 11
7-68

MISSISSIPPI
BOARD OF WATER COMMISSIONERS
416 North State Street
Jackson, Mississippi 39201

CODED

WATER WELL DRILLERS LOG

July 11 1968 J.T. Conington Amite
date well completed firm name county well located


LANDOWNER: Robert Parrish
Centerville, Miss
(mailing address)

description of formations encountered	from	to
clay	0	45
clay	45	80
Sand	80	124

WELL LOCATION:
sec 23 T. 2 N R. 2 E
12 miles West of Liberty
(distance) (direction) (nearest town)

WELL PURPOSE: Home
(home, irrigation, municipal, industrial)

- WELL COMPLETION DATA:
- (1) diameter (inches) 4"
 - (2) total depth (feet) 124'
 - (3) static water level (feet) 90' below above top of ground.
 - (4) casing Plastic, 118' (material) (depth)
4" (size) If telescope see back.
 - (5) screen 6' 124' (length) (depth to top)
4" Plastic (size) (material)
 - (6) pump 1 6 (HP) (yield gpm)
A.C. (type power)
 - (7) electric log (yes or no)
 - (organization running log)
 - (8) how well bottom plugged wood

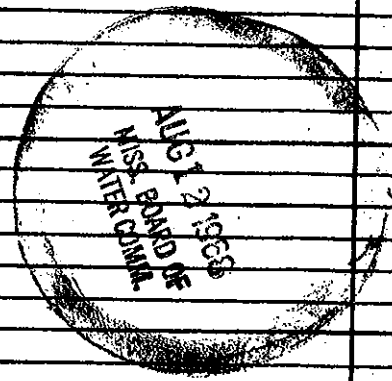

DRILLERS REMARKS: