

CMR 35-1#1

State Well Report

Part 1

Mississippi Department of Environmental Quality
Office of Land and Water Resources
P.O. Box 10631
Jackson, MS 39289-0631
(601)961-5210
(601)354-6938 (fax)

For Office Use Only:

Aquifer: _____
Well #: L-57
L. S. Elevation: _____
E-log #: _____

County: Amite
Permit #: _____
Driller: Gary Rayborn
Date drilling completed: 5/22/08

State Law requires that this report be prepared by the driller in detail and filed with the Department within 30 days of completion of drilling of the well.

Well Owner Information	Well Location
Owner Name: <u>Energy Drilling, Inc.</u>	Latitude: _____ Longitude: _____
Mailing Address: <u>P.O. Box 905</u>	Method of Lat/Long (circle one): Conventional Survey, USGS quad, Hand-held GPS, Survey-grade GPS
<u>Natchez MS 39121</u> City State Zip Code	_____ 1/4 _____ 1/4 Sec <u>10</u> Twn <u>2N</u> Rng <u>2E</u>
Telephone No. <u>(601) 446-5259</u>	Distance <u>2.1</u> Miles Direction <u>South</u> of Nearest Town <u>Gloster</u>

Well Data

Purpose of Well (circle one) Home Industrial Public Supply Irrigation Fish Culture Other: Rlg Supply

Date well drilling started: 5/22/08 Date well drilling completed: 5/22/08

If flowing, method of flow regulation: Valve _____ Other (describe) _____

Static Water Level: 20' feet above of below (circle one) land surface Date measured: 5/22/08

Method of Measurement (circle one) steel tape electric tape air line other: _____

Hole depth: 120' Well depth: 120' Well grouted to a depth of 10 feet

Type of grout (circle one): Cement Bentonite Mix

Casing length: 100 feet Casing diameter: 4 inches Type of casing: PVC

Screen length: 20 feet Screen diameter: 4 inches Type of screen: PVC

Screen slot size: 1020 inches Setting depth: From 100 feet to 120 feet

Type of completion (circle all applicable): Gravel packed Underreamed Telescoped Open hole Natural Development

Other (describe): _____

Top of lap pipe or reduction in casing: _____ feet. If telescoped or more than one screen, describe on back of page


Logs run (circle all applicable): No log run Electric Gamma Ray Density Sonic Neutron Other: _____

Name of organization running log(s): _____

I certify that the well was drilled, constructed, and completed in accordance with all applicable requirements of the Mississippi Department of Environmental Quality and/or the Mississippi Department of Health regulations and state laws.

RAYBORN DRILLING, INC.

0-60

Signature of Water Well Contractor 

Print Name of Water Well Contractor and License No.

RECEIVED
MAY 30 2008
BY: OLWR

1. The first part of the document discusses the importance of maintaining accurate records of all transactions. This is essential for ensuring the integrity of the financial statements and for providing a clear audit trail. The records should be kept up-to-date and should be easily accessible to all relevant parties.

2. The second part of the document outlines the various methods used to collect and analyze data. These methods include direct observation, interviews, and the use of statistical techniques. Each method has its own strengths and weaknesses, and it is important to choose the most appropriate method for the specific research objectives.

3. The third part of the document describes the process of data analysis. This involves identifying patterns and trends in the data, and testing hypotheses using statistical tests. The results of the analysis should be presented in a clear and concise manner, using tables and graphs where appropriate.

4. The fourth part of the document discusses the implications of the findings. These findings have important implications for the theory and practice of the field. They suggest that there is a need for further research in this area, and that the current findings should be used to inform policy and practice.

5. The fifth part of the document concludes the report and provides a summary of the key findings. It also includes a list of references and a list of appendices. The references list the sources of information used in the report, and the appendices provide additional information that is relevant to the study.

6. The sixth part of the document is a list of references. These references include books, articles, and other sources of information that have been used in the report. The references are listed in alphabetical order and provide a clear and concise way to cite the sources of information.

7. The seventh part of the document is a list of appendices. These appendices provide additional information that is relevant to the study. They include a list of abbreviations, a list of symbols, and a list of figures and tables. The appendices are listed in alphabetical order and provide a clear and concise way to cite the additional information.

STATE WELL REPORT

Part 2

Pump Installer's Completion Report
 Mississippi Department of Environmental Quality
 Office of Land and Water Resources
 P.O. Box 10631
 Jackson, MS 39289-0631
 (601)961-5210
 (601)354-6938 (fax)

For Office Use Only:

Aquifer: _____
 Well #: L-57
 Elevation: _____

County: Amite
 Permit #: _____
 Driller: Gary Rayborn
 Date completed: 5/22/08

This report should be prepared by the pump installer in detail and filed with the Department within 30 days of the installation of pump.

Well Owner Information	Well Location
Owner Name: <u> Energy Drilling, Inc. </u>	Latitude: _____ Longitude: _____
Mailing Address: _____ <u> P. O. Box 905 </u> <u> Natchez, MS 39121 </u> <small>City State Zip Code</small>	Method of Lat/Long (circle one): Conventional Survey, USGS quad, Hand-held GPS, Survey-grade GPS _____ ¼ _____ ¼ Sec <u> 10 </u> Twn <u> 2N </u> Rng <u> 2E </u>
Telephone No. <u> (601) 446-5259 </u>	Distance Direction Nearest Town <u> 2.1 Miles South of Gloster </u>

Pump Type Circle one	Power Type Circle one
Air Lift Jet <input type="radio"/> <u> Submersible </u>	Diesel Engine Gasoline Engine Natural Gas
Bucket Piston <input type="radio"/> Turbine <input type="radio"/>	<u> Electric Motor </u> Hand <input type="radio"/> Tractor PTO <input type="radio"/>
Centrifugal Rotary <input type="radio"/> Flowing Well <input type="radio"/>	Windmill Other (specify): _____
Other (specify): _____	Horse Power Rating of Motor: <u> 5 </u>
Date Pump Installed: <u> 5/23/08 </u>	Setting Depth: <u> 63' </u> feet
Rated Pump Capacity: <u> 60 </u> Gallons Per Minute	Number of Stages: <u> 11 </u>

Pump Test Data	Method of Measuring Water Level Circle one
Date Well Tested: <u> 5/23/08 </u>	<u> Air Line </u> Electric Measuring Line <input type="radio"/> Steel Tape <input type="radio"/>
Static Water Level (A): <u> 20 </u> Feet Below Land Surface	Other (specify): _____
Pumping Water Level (B): _____ Feet Below Land Surface	For flowing well, measured shut in head: _____ feet
Drawdown [(B) - (A)]: _____ Feet Below Land Surface	Well yielded <u> 60 </u> GPM with a drawdown of _____ feet after _____ hours of pumping
Test Pumping Rate: <u> 60 </u> Gallons Per Minute	
Duration of Pump Test (minimum 4 hours): _____ hours	

I HEREBY CERTIFY that the above statements are true to the best of my knowledge.

 Gary Rayborn 0-60 _____
 Print Name of Pump Installer and License No. (if applicable) Signature of Pump Installer

RECEIVED
 MAY 30 2008
 BY: OLWR

1. The first part of the document discusses the importance of maintaining accurate records of all transactions. This is essential for ensuring the integrity of the financial statements and for providing a clear audit trail. The records should be kept up-to-date and should be easily accessible to all relevant parties.

2. The second part of the document outlines the procedures for handling discrepancies. It is important to identify any errors as soon as they are discovered and to take appropriate corrective action. This may involve reviewing the original documents, contacting the relevant parties, and making necessary adjustments to the records.

3. The third part of the document discusses the role of the internal control system. This system is designed to prevent and detect errors and fraud. It should be regularly reviewed and updated to ensure that it remains effective. The internal control system should be based on the principles of segregation of duties, authorization, and documentation.

4. The fourth part of the document outlines the requirements for the external audit. The external auditor is responsible for providing an independent opinion on the financial statements. The company should ensure that the auditor has access to all relevant information and that the audit process is conducted in a transparent and professional manner.

5. The fifth part of the document discusses the importance of communication. All relevant parties should be kept informed of the progress of the audit and of any issues that arise. This will help to ensure that the audit is completed in a timely and efficient manner and that any necessary actions are taken.

6. The sixth part of the document outlines the requirements for the final report. The report should provide a clear and concise summary of the findings of the audit and should include recommendations for improvement. The report should be distributed to all relevant parties and should be used as a basis for action.

7. The seventh part of the document discusses the importance of ongoing monitoring. The internal control system should be regularly reviewed and updated to ensure that it remains effective. This should be done in conjunction with the external audit and should involve all relevant parties.

8. The eighth part of the document outlines the requirements for the final review. The final review should be conducted by a senior member of the organization and should involve all relevant parties. The review should ensure that all requirements have been met and that the final report is accurate and complete.

9. The ninth part of the document discusses the importance of documentation. All relevant documents should be kept up-to-date and should be easily accessible to all relevant parties. This will help to ensure that the audit process is conducted in a transparent and professional manner.

10. The tenth part of the document outlines the requirements for the final sign-off. The final sign-off should be provided by the senior member of the organization and should involve all relevant parties. The sign-off should ensure that all requirements have been met and that the final report is accurate and complete.

11. The eleventh part of the document discusses the importance of training. All relevant parties should be trained in the requirements of the audit process and in the use of the internal control system. This will help to ensure that the audit process is conducted in a transparent and professional manner.

12. The twelfth part of the document outlines the requirements for the final review. The final review should be conducted by a senior member of the organization and should involve all relevant parties. The review should ensure that all requirements have been met and that the final report is accurate and complete.

13. The thirteenth part of the document discusses the importance of communication. All relevant parties should be kept informed of the progress of the audit and of any issues that arise. This will help to ensure that the audit is completed in a timely and efficient manner and that any necessary actions are taken.

14. The fourteenth part of the document outlines the requirements for the final report. The report should provide a clear and concise summary of the findings of the audit and should include recommendations for improvement. The report should be distributed to all relevant parties and should be used as a basis for action.

15. The fifteenth part of the document discusses the importance of ongoing monitoring. The internal control system should be regularly reviewed and updated to ensure that it remains effective. This should be done in conjunction with the external audit and should involve all relevant parties.

16. The sixteenth part of the document outlines the requirements for the final sign-off. The final sign-off should be provided by the senior member of the organization and should involve all relevant parties. The sign-off should ensure that all requirements have been met and that the final report is accurate and complete.

If well telescopes please sketch below and show depths.

L-57


Ground Level

--	--


Description of Formations Encountered	From	To
Chalk	0	15
Gravel and few Gravel	15	80

If more than one screen, show location of each on sketch

Sketch the property layout and include the following: 1) the well location; 2) any permanent structures on the property that may aid in locating the well; 3) any roads, power lines, or other items that may aid in locating the property and the well; 4) indicate direction.

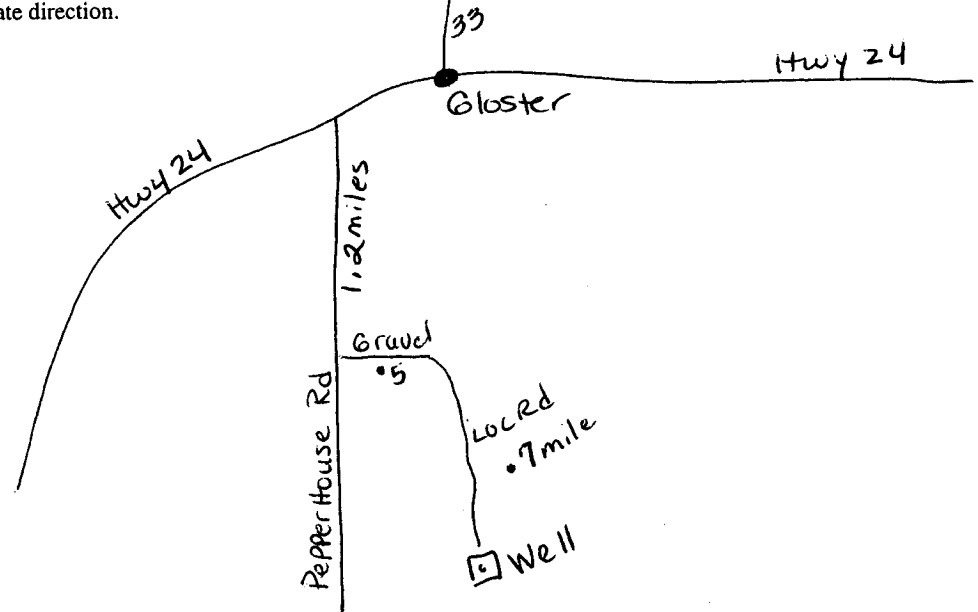

Landowner Name: _____



Signature of Water Well Contractor

RECEIVED
MAY 30 2008
BY: OLWR