

AMITE
M2

6-22-66 MISSISSIPPI BOARD OF WATER COMMISSIONERS

WATER WELL DRILLERS LOG

CODED

Date: 6-22, 1966, Driller: R. J. Dippard County: Amite
(When well drilled) (Name) (Where well is located)

(1) Owner of Land	Description & Color of Materials Sand, Clay, Red Clay, Shell, etc.	Thick- ness Feet	Depth Feet
<u>Albert Hayes</u> (Name) <u>Liberty Rt 5</u> (Address) <u>Sec 37-T2N-R3E</u>	<u>Top Soil</u>	<u>0</u>	<u>15</u>
	<u>Red Sand</u>	<u>15</u>	<u>30</u>
	<u>gravel sand</u>	<u>30</u>	<u>60</u>
(2) Location: <u>SE 1/4, S 1/2, Sec 37, T2N, R3E</u>	<u>Red Sand</u>	<u>45</u>	<u>75</u>
<u>8</u> miles <u>South</u> of <u>Liberty</u>	<u>gravel</u>	<u>85</u>	<u>90</u>
(distance) (direction) (Nearest Town)	<u>White Chalk</u>	<u>90</u>	<u>120</u>
(3) Topography: <input checked="" type="checkbox"/> (Hilly) <input type="checkbox"/> (Flat) <input type="checkbox"/> (Level)	<u>White sand & gravel</u>	<u>120</u>	<u>145</u>
(4) Purpose of Well: <input checked="" type="checkbox"/> (Domestic Irrigation) <input type="checkbox"/> (Municipal, Industrial, Other)	<u>white Chalk</u>	<u>145</u>	

Information upon completion of well:

- (1) Diameter 2 inches.
- (2) Total Depth 147 feet.
- (3) Water Level 90 feet below top of ground.
- (4) Cased to 139', Size 2
- (5) Screen: Size 1/4", Length 3
- (6) Were any formations sealed against pollution?
yes, no,

If YES depth of formation _____


Why _____

Drillers Remarks: _____

Yield in gpm: 4

Size pump: 6" Red type

Type power: Electric

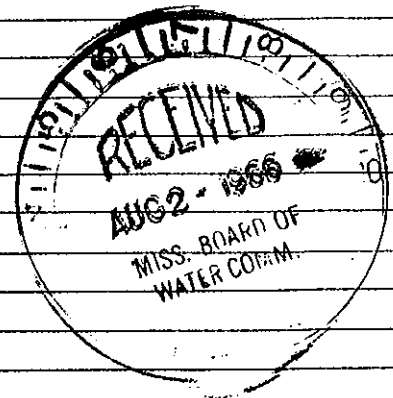

Mail this copy to Board of Water Commissioners 429 Miss. St. Jackson, Miss.