

AMITE
M3

6-23-66 MISSISSIPPI BOARD OF WATER COMMISSIONERS

CODED

WATER WELL DRILLERS LOG

Date: 6-23, 1966, Driller: W J Fitzmaurice County Amite
(When well drilled) (Name) (Where well is located)

(1) Owner of Land:	Description & Color of Materials Sand, Clay, Red Clay, Shell, etc.	Thick- ness Feet	Depth Feet
<u>Doyle Morris</u>	<u>Top soil & clay</u>	<u>0</u>	<u>20</u>
<u>Rt 1 Box 120 Chester</u>	<u>Red chalk</u>	<u>20</u>	<u>45</u>
(Address)	<u>Red sandy sand</u>	<u>45</u>	<u>80</u>
(2) Location <u>SW 1/4, S 1/4, Sec. 36 T2N R3E</u>	<u>Red chalk</u>	<u>80</u>	<u>90</u>
<u>9</u> miles <u>South</u> , of <u>Liberty</u>	<u>Comp. sandstone</u>	<u>90</u>	<u>105</u>
(distance) (direction) (Nearest Town)	<u>White chalk</u>	<u>105</u>	
(3) Topography: <input checked="" type="checkbox"/> (Hilly) <input type="checkbox"/> (Flat) <input type="checkbox"/> (Level)			
(4) Purpose of Well: <input checked="" type="checkbox"/> (Domestic Irrigation) <input type="checkbox"/> (Municipal, Industrial, Other)			

Information upon completion of well:

- (1) Diameter 4 inches.
- (2) Total Depth 100' feet.
- (3) Water Level 50 feet below top of ground.
- (4) Cased to 92, Size 4"
- (5) Screen: Size 4", Length 8'
- (6) Were any formations sealed against pollution?
 yes, no.

If YES depth of formation _____


Why _____

Drillers Remarks: _____

Yield in gpm: 10

Size pump: 1 HP

Type power: Electric

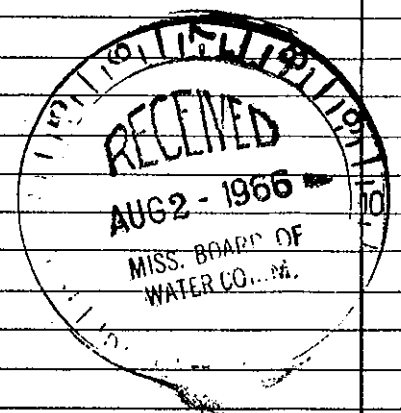

Mail this copy to Board of Water Commissioners 429 Miss. St. Jackson, Miss.