

WHITE  
M7  
5-11-65

MISSISSIPPI BOARD OF WATER COMMISSIONERS

118

WATER WELL DRILLERS LOG

**CODED**

Date: 5-11, 1965, Driller: Chester Reeves County Smith  
(Name)

(1) Owner of Land: W. Wood Roberts  
(Name)  
RT-5, Liberty  
(Address)

(2) Location: 1/4, 1/4, Sec. 12, 2R3  
5 miles S.W. Liberty  
(distance) (direction) (Nearest Town)

(3) Topography: Hilly  
(Hilly) (Flat) (Level)

(4) Purpose of Well: Domestic  
(Domestic Irrigation, Municipal, Industrial, Other)

Description & Color of Materials Sand, Clay, Red Clay, Shell, etc.	Thick- ness Foot	Depth Foot
<u>Surface clay</u>	<u>20</u>	<u>20</u>
<u>Red sandy soil</u>	<u>25</u>	<u>45</u>
<u>Hard clay gravel</u>	<u>15</u>	<u>60</u>
<u>Loose clay gravel</u>	<u>30</u>	<u>90</u>
<u>Sand &amp; gravel</u>	<u>13</u>	<u>103</u>

**CODED**


Information upon completion of well:

- (1) Diameter 4 inches.
- (2) Total Depth 103 feet.
- (3) Water Level 79 feet below top of ground.
- (4) Cased to Bottom Size 4"
- (5) Screen: Size 4", Length 6'
- (6) Were any formations sealed against pollution?  
no

If YES depth of formation \_\_\_\_\_

Why \_\_\_\_\_

Drillers Remarks: no previous well at location -

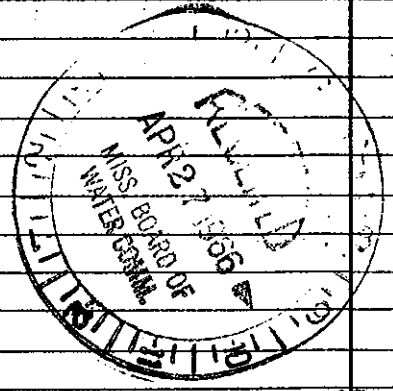

BEEVES WELL & PUMP CO.  
P. O. BOX 71 -- PHONE 684-1451  
McCOMB, MISS.

(Use Back Side)

Well No.