

AMITE
 MS
 3-68

MISSISSIPPI
 BOARD OF WATER COMMISSIONERS
 416 North State Street
 Jackson, Mississippi 39201

CODED

WATER WELL DRILLERS LOG


March 17 1968 J. T. Washington Amite
 date well completed firm name county well located

LANDOWNER	description of formations encountered	from	to
William Wilson	sand	0	50
Gillsburg, Miss.	clay	50	150
(mailing address)	sand	150	190

WELL LOCATION:
 sec 23 T 2 N R 3 E
 8 miles west of Liberty
 (distance) (direction) (nearest town)

WELL PURPOSE: none
 (home, irrigation, municipal, industrial)

- WELL COMPLETION DATA:
- diameter (inches) 4"
 - total depth (feet) 190'
 - static water level (feet) 5' below top of ground.
 - casing Plastic, 140'
 (material) (depth)
 (size) If telescope see back.
 - screen 6" 184'
 (length) (depth to top)
 1/2" Plastic
 (size) (material)
 - pump 1/2 HP 14
 (HP) (yield gpm)
 AC
 (type power)
 - electric log (yes or no)
 - organization running log
 - how well bottom plugged none

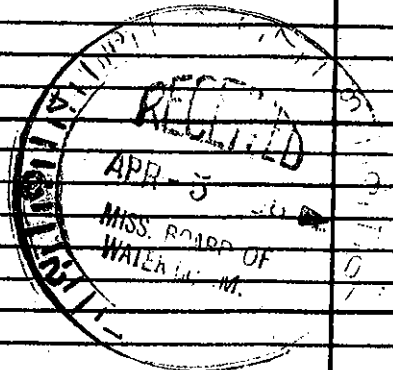

DRILLERS REMARKS: