

AMITE
M9
2-68

MISSISSIPPI
BOARD OF WATER COMMISSIONERS
416 North State Street
Jackson, Mississippi 39201

CODED

WATER WELL DRILLERS LOG

Feb 70 date well completed 68 Reeves Well Drilling Co. Amite county well located

LANDOWNER: George Robb
RFD 5
Liberty
(mailing address)


WELL LOCATION:
sec 17 T. 2 N R. 3 E
6-7 miles WSW of Liberty
(distance) (direction) (nearest town)

WELL PURPOSE: Home
(home, irrigation, municipal, industrial)

WELL COMPLETION DATA:

(1) diameter (inches) 11 1/2"
(2) total depth (feet) 96
(3) static water level (feet) 74 below top of ground
(4) casing Plastic bottom
(material) (depth)
(size) If telescope see back.
(5) screen 6' 90'
(length) (depth to top)
4" Plastic
(size) (material)
(6) pump oil pump
(type power) (yield gpm)
(7) electric log NO
(yes or no)
(organization running log)

description of formations encountered	from	to
Brown sandy clay	0	12
Red clay & gravel	12	30
Red sand & chalk	30	57
Small gravel & sand	57	62
Red chalk	62	70
Sand & chalk	70	88
Small gravel & sand	88	96
Bottom of gravel band		

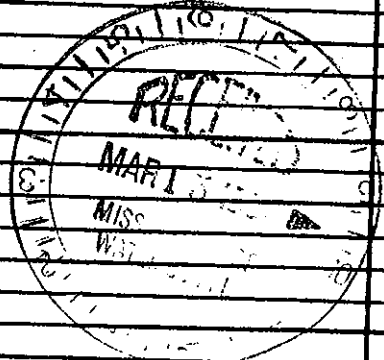

(8) how well bottom plugged: wood chips

DRILLERS REMARKS:
Set 2" well giving trouble