

AMITE  
M10  
2-68

MISSISSIPPI  
BOARD OF WATER COMMISSIONERS CODED  
416 North State Street  
Jackson, Mississippi 39201

WATER WELL DRILLERS LOG

Feb 21 1968 Reverwell Drilling Amite  
date well completed firm name county well located


LANDOWNER L. D. Carney  
RF DZ  
Slater, Miss  
(mailing address)

WELL LOCATION:  
sec. 18 T. 2 N R. 3 E  
5 miles SE of Slater  
(distance) (direction) (nearest town)

WELL PURPOSE: Home  
(home, irrigation, municipal, industrial)

- WELL COMPLETION DATA:
- (1) diameter (inches) 4"
  - (2) total depth (feet) 98
  - (3) static water level (feet) 61 below above top of ground.
  - (4) casing Plastic Bottom  
(material) (depth)
  - (size) if telescope see back.
  - (5) screen 6' 92'  
(length) (depth to top)
  - 4" Plastic  
(size) (material)
  - (6) pump 1/2 HP 1-2  
(HP) (yield gpm)
  - Electric  
(type power)
  - (7) electric log NO  
(yes or no)
  - (organization running log)
  - (8) how well bottom plugged plug wooden

description of formations encountered	from	to
Red clay	0	10
Red sandy clay	10	35
Red silty clay	35	60
Red gravel & sand	60	75
Red sandy clay	75	88
Red gravel & sand	88	98

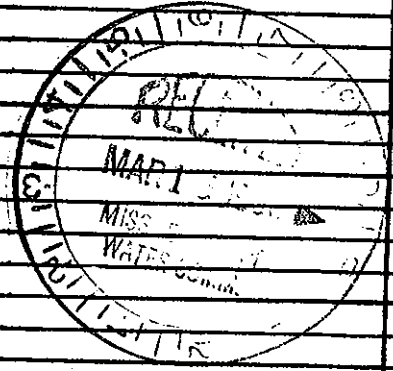

DRILLERS REMARKS:  
Red 2' well  
rod