

AMITE
M50
4-6-73

MISSISSIPPI
BOARD OF WATER COMMISSIONERS
416 North State Street
Jackson, Mississippi 39201

CODED

WATER WELL DRILLERS LOG

date well completed April 1974 firm name Chester Keener county well located Amite

LANDOWNER: W. J. Keener
Amite
RFD - Blaster
(mailing address)

description of formations encountered	from	to
Red Clay	0	16
Red Sand	16	106
Small gravel & sand	106	123


WELL LOCATION:
sec. 22 T. 2 N. R. 3 E
7 miles ENE of Centerville
(distance) (direction) (nearest town)

WELL PURPOSE: Home
(home, irrigation, municipal, industrial)

- WELL COMPLETION DATA:
- (1) diameter (inches) 4"
 - (2) total depth (feet) 123
 - (3) static water level (feet) 83 below top of ground. 23 above
 - (4) casing Plast bottom
(material) (depth)
 - (size) if telescope see back.
 - (5) screen 6' 11'
(length) (depth to top)
 - 4" Plast
(size) (material)
 - (6) pump 3/4 sub SS
(HP) (yield gpm)
 - Electric
(type power)
 - (7) electric log NO
(yes or no)
 - (organization running log)
 - (8) how well bottom plugged wooden plug

CODED

DRILLERS REMARKS:
New location -

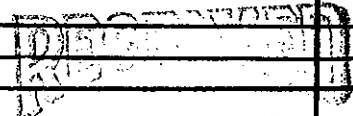

MAY 24 1974